

MISSISSIPPI DEPARTMENT OF NATURAL RESOURCES

Bureau of Land and Water Resources

Southport Mall

P.O. Box 10631

Jackson, Mississippi 39209

WATER WELL DRILLERS LOG

M 2137
JACKSON
2-20-85

2-20-85 date well completed
Coast Water Well Sew. firm name
Jackson county well located

LANDOWNER: Jesse Barrow
500 Barrow Rd.
Pascagoula, Miss.
(mailing address)

WELL LOCATION:
sec 23 T 6 N R 5 E
4 miles East of Pascagoula
(distance) (direction) (nearest town)

WELL PURPOSE: Home
(home, irrigation, municipal, industrial)

- WELL COMPLETION DATA:
- (1) diameter (inches) 2"
 - (2) total depth (feet) 240'
 - (3) static water level (feet) 45' below top of ground
 - (4) casing PVC, 230' (material) (depth)
 - (5) screen 2" (size), 10' (length), 230' (depth to top), PVC (material)
 - (6) pump 1 (HP), 8 (yield gpm), Elect. (type power)
 - (7) electric log (yes or no) No (organization running log)
 - (8) how well bottom plugged Salt Wash Valve

description of formations encountered	from	to
Top soil	0	2'
Red Clay	2'	15'
Coarse sand (white)	15'	90'
Coarse sand & shell sand	90'	147'
Blue Clay	147'	175'
Coarse white sand	175'	240'
5 1/2" PVC Tail Pipe		


RECEIVED
APR 23 1985

Department of Natural Resources
Bureau of Land & Water Resources

DRILLERS REMARKS:

If well telescopes please sketch and show depths.

GROUND LEVEL

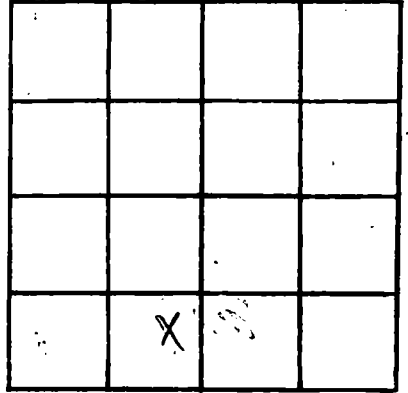

SECTION 23

Please indicate well location X.

ADDITIONAL INFORMATION

If more than one screen,
show locations of each on sketch.