

MISSISSIPPI DEPARTMENT OF NATURAL RESOURCES

Bureau of Land and Water Resources

Southport Mall

P.O. Box 10631

Jackson, Mississippi 39209

WATER WELL DRILLERS LOG

Jackson  
M 2139  
4-25-85

L

4-25-85 date well completed  
Coastal Water Well Sew. firm name  
Jackson county well located

LANDOWNER: Henry P. Grady  
12001 Chatsworth Rd.  
Pascagoula, Miss.  
(mailing address) 39567

WELL LOCATION:  
sec. 20 T. 6 N. R. 4 E  
5 miles EAST of HELENA  
(distance) (direction) of (nearest town)

WELL PURPOSE: Home  
(home, irrigation, municipal, industrial)

WELL COMPLETION DATA:

(1) diameter (inches) 2"

(2) total depth (feet) 345'

(3) static water level (feet) flowing below above  
top of ground.

(4) casing PVC 325'  
(material) (depth)

2" If telescope see back.  
(size)

(5) screen 20' 325'  
(length) (depth to top)

2" PVC  
(size) (material)

(6) pump Blue HP yield gpm  
(type power)

(7) electric log No  
(yes or no)

organization running log

(8) Jack what value  
how well bottom plugged

description of formations encountered	from	to
Top soil	0	3'
Red sand, sand & gravel	3'	25'
Blue Clay	25'	52'
Blue Clay & shell sand	52'	55'
Blue Clay	55'	71'
White coarse sand	71'	106'
Blue Clay	106'	171'
Blue Clay & shell sand	171'	226'
Blue Clay	226'	239'
Blue Clay & shell sand	239'	256'
gray coarse sand	256'	340'
gray coarse sand & gravel	340'	345'
(5 ft. 2" PVC Tail Pipe)		


RECEIVED  
JUL 11 1985

Department of Natural Resources  
Bureau of Land & Water Resources

DRILLERS REMARKS:

If well telescopes please sketch and show depths.

GROUND LEVEL

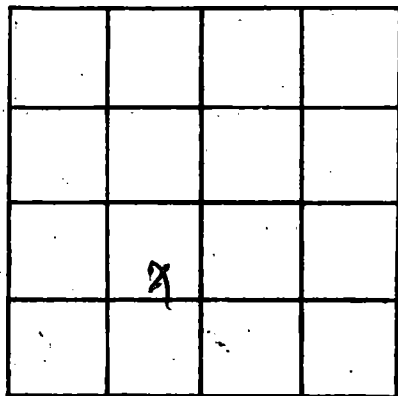

SECTION 20

Please indicate well location X.

ADDITIONAL INFORMATION

If more than one screen,  
show locations of each on sketch.