

MISSISSIPPI DEPARTMENT OF NATURAL RESOURCES

Bureau of Land and Water Resources

Southport Mall

P.O. Box 10631

Jackson, Mississippi 39209

WATER WELL DRILLERS LOG

JACKSON
M 2 (40)

5-29-85
date well completed

Coast Water Well Sew.
firm name

Jackson
county well located

LANDOWNER: Terry Moore
P.O. Box 1873
Escatawpa, Miss.
(mailing address) 37564

description of formations encountered	from	to
Top soil	0	3'
Blue Clay	3'	6'
Sand & pea gravel	6'	80'
Blue Clay	80'	110'
Coarse white sand	110'	172'

WELL LOCATION:
sec. 35 T 6 R 5
3 miles SE HELENA
(distance) (direction) (nearest town)

WELL PURPOSE: None
(home, irrigation, municipal, industrial)

- WELL COMPLETION DATA:
- diameter (inches) 2"
 - total depth (feet) 172'
 - static water level (feet) 20' ^{below} ~~above~~ top of ground.
 - casing PVC, 162' (material) (depth)
2" (size) if telescope see back.
 - screen 10' (length), 162' (depth to top)
2" (size), PVC (material)
 - pump 1/2 HP, 12 (type power) (yield gpm)
 - electric log No (yes or no)
(organization running log)
 - how well bottom plugged: Back wash valve


RECEIVED
JUL 10 1985

Department of Natural Resources
Bureau of Land & Water Resources

DRILLERS REMARKS:

If well telescopes please sketch and show depths.

GROUND LEVEL

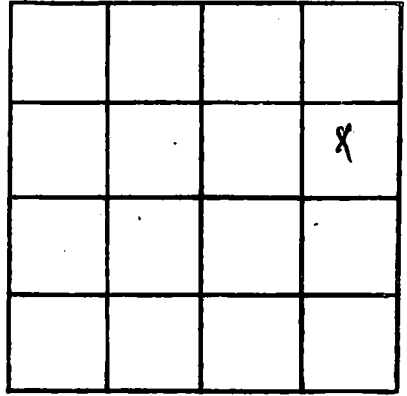

SECTION 35

Please indicate well location X.

ADDITIONAL INFORMATION

If more than one screen, show locations of each on sketch.