

Jackson  
 M 243  
 4-5-85

MISSISSIPPI  
 BOARD OF WATER COMMISSIONERS  
 416 North State Street  
 Jackson, Mississippi 39201

L

WATER WELL DRILLERS LOG

4/5 1985 Pierce Drilling Jackson  
 date well completed firm name county well located

LANDOWNER: Charles Foster  
Escatawpa, MS

description of formations encountered	from	to
<u>Top Soil</u>	<u>0</u>	<u>15</u>
<u>clay</u>	<u>15</u>	<u>30</u>
<u>good sand</u>	<u>30</u>	<u>120</u>
<u>clay</u>	<u>120</u>	<u>220</u>
<u>good sand</u>	<u>220</u>	<u>245</u>

(mailing address)  
 WELL LOCATION:  
 sec. 5 T. 6 N R. 5 E  
3 miles Southwest of Big Point  
 (distance) (direction) (nearest town)

WELL PURPOSE:  
 home,  irrigation, municipal, industrial

WELL COMPLETION DATA:  
 (1) diameter (Inches) 2"  
 (2) total depth (feet) 240'  
 (3) static water level (feet) 30'  below above top of ground.  
 (4) casing plastic, 240'  
 (material) (depth)  
0 If telescope see back.  
 (size)  
 (5) screen 5', 245'  
 (length) (depth to top)  
006, plastic  
 (size) (material)  
 (6) pump 1 12  
 (HP) (yield gpm)  
electric  
 (type power)  
 (7) electric log (yes or no) \_\_\_\_\_  
 (organization running log) \_\_\_\_\_  
 (8) how well bottom plugged BW


DRILLERS REMARKS: \_\_\_\_\_

RECEIVED

JUL 23 1985

If well telescopes please sketch and show depths.

GROUND LEVEL

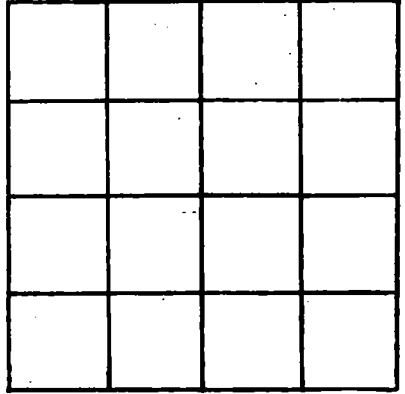

SECTION \_\_\_\_\_

Please indicate well location X.

ADDITIONAL INFORMATION

If more than one screen, show locations of each on sketch.