

MISSISSIPPI DEPARTMENT OF NATURAL RESOURCES

Bureau of Land and Water Resources

Southport Mall

P.O. Box 10631

Jackson, Mississippi 39209

WATER WELL DRILLERS LOG

JACKSON
M 9/45

Jan 27-85
date well completed

Coast Water Well Sew. Jackson
firm name county well located

LANDOWNER: James Vincent
Hawthorn Construction Co.
P.O. Box 7805
Mass Pond, Miss.
(mailing address) 37563

description of formations encountered	from	to
Top soil	0	1'
White coarse sand	1'	3'
Red Clay	3'	10'
Blue Clay	10'	43'
Red coarse sand & gravel	43'	103'
Blue Clay	103'	148'
Gray Med. Sand	148'	180'
Gray coarse sand	180'	205'
Blue Clay	205'	208'
5' ft. 2" PVC Tail Pipe		


WELL LOCATION:

sec. 6 T. 6 S. R. 5 E.
3 miles SW of Big Point
(distance) (direction) (nearest town)

WELL PURPOSE: Home
(home, irrigation, municipal, industrial)

WELL COMPLETION DATA:

- (1) diameter (inches) 2"
- (2) total depth (feet) 208'
- (3) static water level (feet) 24' ^{below} _{above} top of ground.
- (4) casing PVC, 198'
(material) (depth)
2" (size) if telescope see back.
- (5) screen 10', 198'
(length) (depth to top)
2", PVC
(size) (material)
- (6) pump _____ (HP) _____ (yield gpm)
(type power)
- (7) electric log No.
(yes or no)
(organization running log)
- (8) how well bottom plugged
back wash valve

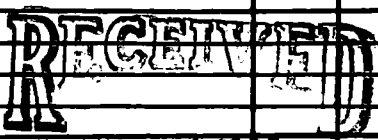


NOV -1 1985

DRILLERS REMARKS:

If well telescopes please sketch and show depths.

GROUND LEVEL

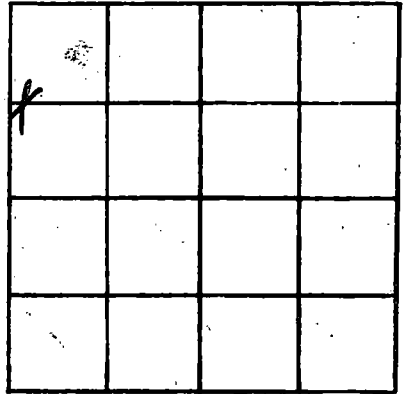

SECTION _____

Please indicate well location X.

ADDITIONAL INFORMATION

If more than one screen, show locations of each on sketch.