

MISSISSIPPI DEPARTMENT OF NATURAL RESOURCES

Bureau of Land and Water Resources

Southport Mall

P.O. Box 10631

Jackson, Mississippi 39209

WATER WELL DRILLERS LOG

JACKSON  
M 2K96

7-30-85 19  
date well completed

Coast Water Well Serv. Jackson.  
firm name county well located

LANDOWNER: Susan Turner  
Demoney Rd  
Passazula, Ms  
(mailing address)

WELL LOCATION:  
sec. 32 T. 6 S. R. 4 E.  
10 miles NE of CROSS POINT  
(distance) (direction) (nearest town)

WELL PURPOSE:  
(home, irrigation, municipal, industrial)

WELL COMPLETION DATA:

- (1) diameter (inches) 2"
- (2) total depth (feet) 150'
- (3) static water level (feet) 6' <sup>below</sup>/<sub>above</sub> top of ground.
- (4) casing PVC, 140' (material) (depth)  
2" (size) if telescope see back.
- (5) screen 10' (length), 140' (depth to top)  
2" (size), PVC (material)
- (6) pump (HP) (yield gpm)  
(type power)
- (7) electric log No (yes or no)  
(organization running log)
- (8) how well bottom plugged  
Backwash Valve

| description of formations encountered | from | to   |
|---------------------------------------|------|------|
| Top Soil                              | 0'   | 1'   |
| Red Coarse sand                       | 1'   | 4'   |
| Red & White Clay                      | 4'   | 11'  |
| Gray Coarse sand & Gravel             | 11'  | 56'  |
| Blue Clay & Gravel                    | 56'  | 100' |
| Gray Coarse sand                      | 100' | 150' |

RECEIVED


NOV - 5 1985

DRILLERS REMARKS:

Department of Natural Resources  
Bureau of Land & Water Resources

If well telescopes please sketch and show depths.

GROUND LEVEL

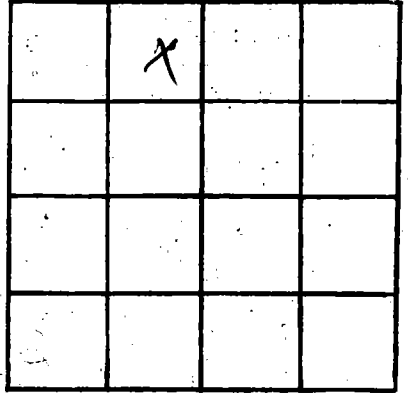

SECTION 32

Please indicate well location X.

ADDITIONAL INFORMATION

If more than one screen, show locations of each on sketch.