

MISSISSIPPI DEPARTMENT OF NATURAL RESOURCES

Bureau of Land and Water Resources

Southport Mall

P.O. Box 10631

Jackson, Mississippi 39209

WATER WELL DRILLERS LOG

JACKSON
M 2148

10-8 1985 Pierce Drilling Co. Jackson
date well completed firm name county well located


LANDOWNER: <u>Jerry Drayton</u>	Description of formations encountered	from	to
<u>Estatawpa.ms</u> (mailing address)	<u>200 Soil</u>	<u>0</u>	<u>10</u>
WELL LOCATION:	<u>Clay</u>	<u>10</u>	<u>25</u>
sec. <u>12</u> T. <u>6</u> N. R. <u>5</u> E.	<u>good Sand</u>	<u>25</u>	<u>160</u>
<u>6</u> miles <u>West</u> of <u>Mobile</u> in	<u>Clay</u>	<u>160</u>	<u>250</u>
(distance) (direction) (nearest town)	<u>good Sand</u>	<u>250</u>	<u>265</u>
WELL PURPOSE:			
(home) Irrigation, municipal, Industrial			
WELL COMPLETION DATA:			
(1) diameter (inches) <u>2"</u>			
(2) total depth (feet) <u>265'</u>			
(3) static water level (feet) <u>50'</u> ^{below} _{above} top of ground.			
(4) casing <u>plastic</u> , <u>260'</u> (material) (depth)			
<u>P</u> if telescope see back. (size)			
(5) screen <u>5'</u> , <u>265'</u> (length) (depth to top)			
<u>006</u> , <u>plastic</u> (size) (material)			
(6) pump <u>1</u> <u>8</u> (HP) (yield gpm)			
<u>electric</u> (type power)			
(7) electric log <u>(yes or no)</u>			
(organization running log)			
(8) how well bottom plugged <u>BW</u>			
REMARKS:			

RECEIVED
NOV 19 1985

Department of Natural Resources
Bureau of Land & Water Resources

If well telescopes please sketch and show depths.

GROUND LEVEL

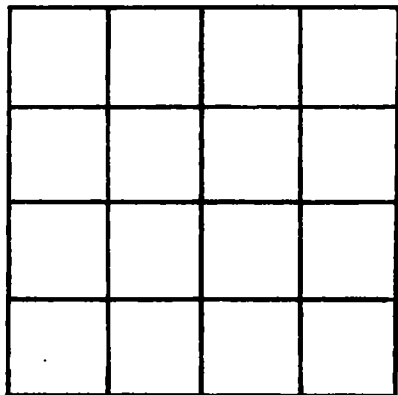

SECTION _____

Please indicate well location X.

ADDITIONAL INFORMATION

If more than one screen,
show locations of each on sketch.