

MISSISSIPPI DEPARTMENT OF NATURAL RESOURCES

Bureau of Land and Water Resources

Southport Mall

P.O. Box 10631

Jackson, Mississippi 39209

WATER WELL DRILLERS LOG

JACKSON
M 21489

10-19-85 date well completed Pierce Drilling Co. firm name Jackson county well located

LANDOWNER: Roy Crane

description of formations encountered

from to

Escatawpa, MS (mailing address)

top soil	0	10
clay	10	20
good sand	20	110
clay	110	230
good sand	230	250

WELL LOCATION:


sec. 32 T. 6 N R. 5 E
7 miles West of Moulton, MS (distance) (direction) (nearest town)

WELL PURPOSE:

(home, irrigation, municipal, industrial)

WELL COMPLETION DATA:

- (1) diameter (inches) 2"
- (2) total depth (feet) 250'
- (3) static water level (feet) 30' below top of ground
- (4) casing (material) plastic, (depth) 240'
- (5) screen (size) 10', (length) 250', (depth to top) 250'
- (6) pump (HP) 1, (yield gpm) 10, (type power) electric
- (7) electric log (yes or no) (no)
- (8) how well bottom plugged BU

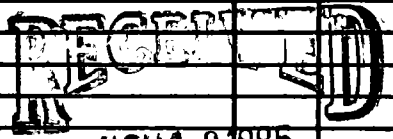

NOV 19 1985

REMARKS:

If well telescopes please sketch and show depths.

GROUND LEVEL

SECTION _____

Please indicate well location X.

ADDITIONAL INFORMATION

If more than one screen, show locations of each on sketch.