

MISSISSIPPI DEPARTMENT OF NATURAL RESOURCES

Bureau of Land and Water Resources

Southport Mall

P.O. Box 10631

Jackson, Mississippi 39209

WATER WELL DRILLERS LOG

JACKSON
M 7150

10-1-85 date well completed 19 Coast Water Well Sew. firm name Jackson county/well located

LANDOWNER: Tom Bennett

description of formations encountered

from to

4212 Idewood Rd
Pascazouly Miss.
(mailing address) 39567

Top soil & Clay 0 5'
Blue Clay 5' 25'
White Sand 25' 60'

WELL LOCATION:

sec 27 T-6 R-5
2 miles EAST of HELENA
(distance) (direction) (nearest town)

Blue Clay 60' 115'
Med. Sand 115' 150'

WELL PURPOSE: Home
(home, irrigation, municipal, industrial)

Blue Clay 150' 190'

WELL COMPLETION DATA:

- (1) diameter (inches) 2"
- (2) total depth (feet) 285'
- (3) static water level (feet) 63' below top of ground
- (4) casing PVC 275'
(material) (depth)
- 2" If telescope see back.
(size)
- (5) screen 10' 275'
(length) (depth to top)
- 2" PVC
(size) (material)
- (6) pump 1 hp 8
(HP) (yield gpm)
- 1/2 hp
(type power)
- (7) electric log No.
(yes or no)

Med. Sand 190' 195'
Blue Clay 195' 270'
Med. Sand 270' 285'
Blue Clay 285' 345'

Includes 60' 2" Tail Pipe to make 345'

(organization running log)

(8) has well bottom plugged Backwash Valve

DRILLERS REMARKS:

60' - 2" Tail Pipe.


RECEIVED

NOV 26 1985

Department of Natural Resources
Bureau of Land & Water Resources

If well telescopes please sketch and show depths.

GROUND LEVEL

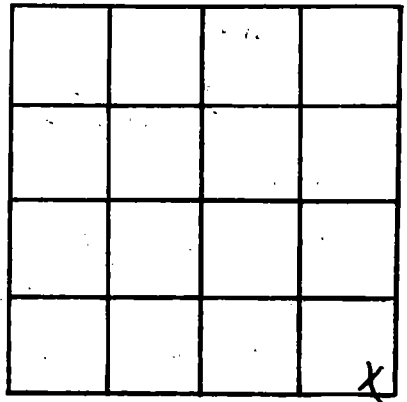

SECTION 27

Please indicate well location X.

ADDITIONAL INFORMATION

Lined area for additional information.

If more than one screen, show locations of each on sketch.