

MISSISSIPPI DEPARTMENT OF NATURAL RESOURCES

Bureau of Land and Water Resources

Southport Mall

P.O. Box 10631

Jackson, Mississippi 39209

WATER WELL DRILLERS LOG

Jackson  
MAISI

10-17-85  
date well completed

Coast Water Well  
firm name

Jackson  
county well located

LANDOWNER: James Allen  
8923 Prairie Brook Rd  
Os. Miss. 39567  
(mailing address)

WELL LOCATION:  
sec. 11 T. 6 S. R. 5 W.  
3 miles NE of HELENA  
(distance) (direction) (nearest town)

WELL PURPOSE: home  
(home, irrigation, municipal, industrial)

WELL COMPLETION DATA:

(1) diameter (inches) 2"  
(2) total depth (feet) 310'  
(3) static water level (feet) 20' <sup>below</sup> <sub>above</sub> top of ground.  
(4) casing PVC, 195',  
(size) (material) (depth)  
2" if telescope see back.  
(5) screen 10', 195'  
(length) (depth to top)  
2", PVC  
(size) (material)  
(6) pump — —  
(HP) (yield gpm)  
—  
(type power)  
(7) electric log no  
(yes or no)  
—  
(organization running log)  
(8) how well bottom plugged  
Backwash valve

description of formations encountered	from	to
Top Soil	0'	3'
Brown Clay	3'	14'
White coarse sand	14'	60'
Coarse sand + Gravel	60'	137'
Blue Clay	137'	145'
Gray coarse sand	145'	205'
Blue Clay	205'	210'
		<u>145'</u>
		<u>10'</u>
		<u>205'</u>
		<u>well</u>


RECEIVED  
NOV 26 1985

Department of Natural Resources  
Bureau of Land & Water Resources

DRILLERS REMARKS:  
5' - 2" tail pipe

If well telescopes please sketch and show depths.

GROUND LEVEL

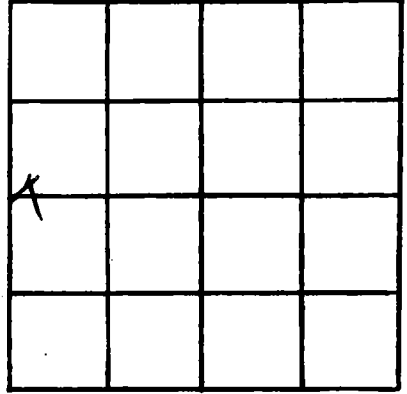

SECTION 11

Please indicate well location X.

ADDITIONAL INFORMATION

If more than one screen,  
show locations of each on sketch.