

MISSISSIPPI DEPARTMENT OF NATURAL RESOURCES
Bureau of Land and Water Resources
 Southport Mall
 P.O. Box 10631
 Jackson, Mississippi 39209
WATER WELL DRILLERS LOG

Jackson
M 2/55

1-21 1980 Pierce Drilling Co. Jackson
 date well completed firm name county well located


LANDOWNER: <u>Jerry Calbeck</u>	description of formations encountered	from	to
<u>Ocean Springs, Ms</u> (mailing address)	<u>top soil</u>	<u>0</u>	<u>20</u>
WELL LOCATION: sec. <u>12</u> T. <u>8</u> N. R. <u>5</u> E <u>4</u> miles <u>South</u> of <u>Fountain Bluff</u> (distance) (direction) (nearest town)	<u>good sand</u>	<u>20</u>	<u>100</u>
WELL PURPOSE: <u>(home) irrigation, municipal, industrial</u>	<u>clay</u>	<u>100</u>	<u>150</u>
WELL COMPLETION DATA:	<u>good sand</u>	<u>150</u>	<u>195</u>
(1) diameter (inches) <u>2"</u>			
(2) total depth (feet) <u>195'</u>			
(3) static water level (feet) <u>30'</u> <u>below</u> top of ground.			
(4) casing <u>plastic, 190'</u> (material) (depth)			
<u>0</u> if telescope see back. (size)			
(5) screen <u>5'</u> , <u>195'</u> (length) (depth to top)			
<u>006</u> , <u>plastic</u> (size) (material)			
(6) pump <u>1</u> <u>10</u> (HP) (yield gpm)			
<u>electric</u> (type power)			
(7) electric log <u>(yes or no)</u>			
<u>(organization running log)</u>			
(8) how well bottom plugged <u>BW</u>			

RECEIVED
 FEB 12 1980
 Department of Natural Resources
 Bureau of Land & Water Resources

DRILLERS REMARKS:

If well telescopes please sketch and show depths.

GROUND LEVEL

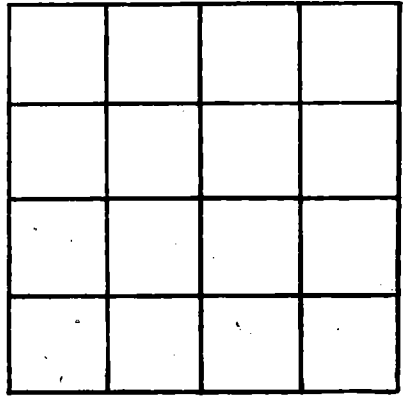

SECTION _____

Please indicate well location X.

ADDITIONAL INFORMATION

Lined area for additional information, consisting of approximately 20 horizontal lines.

If more than one screen, show locations of each on sketch.