

MISSISSIPPI DEPARTMENT OF NATURAL RESOURCES

Bureau of Land and Water Resources

Southport Mall

P.O. Box 10631

Jackson, Mississippi 39209

WATER WELL DRILLERS LOG

JACKSON
M 2157

3-17-86

Good water well

Jackson

date well completed

firm name

county well located

LANDOWNER	description of formations encountered	from	to
Lefty Sanderson 9328 Saracenma Pocahontas mo (mailing address) 3936	top soil	0	2
	White coarse sand + gravel	2	85
	Blue Clay	85	100
	White coarse sand + gravel	100	130
	Blue Clay	130	132
	Gray med sand	132	138
	Blue Clay	138	163
			158
			148
			10
			well 158

LANDOWNER: Lefty Sanderson
9328 Saracenma
Pocahontas mo
(mailing address) 3936

WELL LOCATION:
sec 32 T 6 N R 5 E
3 miles NE of ESCATAWPA
(distance) (direction) (nearest town)

WELL PURPOSE: Home
(home, irrigation, municipal, industrial)

WELL COMPLETION DATA:

- (1) diameter (inches) 2"
- (2) total depth (feet) 163'
- (3) static water level (feet) 30' below top of ground
- (4) casing (material) PVC (depth) 148'
- (size) 2" if telescope see back.
- (5) screen (length) 10' (depth to top) 148'
- (size) 2" (material) PVC
- (6) pump (HP) 1 (yield gpm) 12
- (type power) Elect
- (7) electric log no (yes or no)
- (organization running log)

(8) how well bottom plugged backwash valve


DRILLERS REMARKS: 5' 2" PVC tail pipe

RECEIVED
MAY 12 1986

Department of Natural Resources
Bureau of Land & Water Resources

If well telescopes please sketch and show depths.

GROUND LEVEL

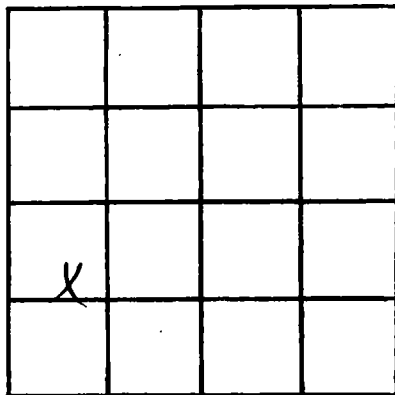

SECTION 32

Please indicate well location X.

ADDITIONAL INFORMATION

If more than one screen,
show locations of each on sketch.