

MISSISSIPPI DEPARTMENT OF NATURAL RESOURCES

Bureau of Land and Water Resources

Southport Mall

P.O. Box 10631

Jackson, Mississippi 39209

WATER WELL DRILLERS LOG

JACKSON
M 2158

3-30 1986 Pierce Drilling Co. Jackson
 date well completed firm name county well located

LANDOWNER: Coper Realty
Waldo Rd
Pascagoula, Ms
 (mailing address)

description of formations encountered	from	to
<u>top soil</u>	<u>0</u>	<u>10</u>
<u>Clay</u>	<u>10</u>	<u>40</u>
<u>good sand</u>	<u>40</u>	<u>60</u>
<u>Clay</u>	<u>60</u>	<u>80</u>
<u>good sand</u>	<u>80</u>	<u>93</u>

WELL LOCATION:
 sec. 1 T. 6 N R. 5 E
4 miles S of Big Point
 (distance) (direction) (nearest town)

WELL PURPOSE:
(home, irrigation, municipal, industrial)

WELL COMPLETION DATA:

(1) diameter (inches) 2"

(2) total depth (feet) 93'

(3) static water level (feet) 20 ^{below} above top of ground

(4) casing plastic, 88'
 (material) (depth)
0 if telescope see back.
 (size)

(5) screen 5', 93'
 (length) (depth to top)
006, plastic
 (size) (material)

(6) pump 1 12
 (HP) (yield gpm)
electric
 (type power)


(7) electric log (yes or no)
(organization running log)

(8) how well bottom plugged Blu

DRILLERS REMARKS:

If well telescopes please sketch and show depths.

GROUND LEVEL

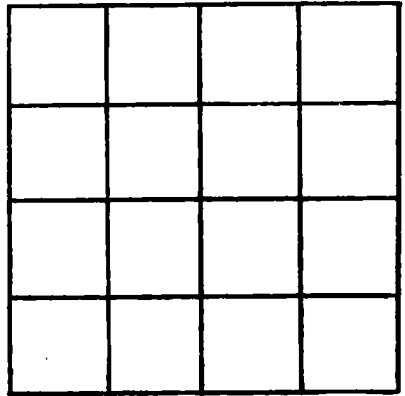

SECTION _____

Please indicate well location X.

ADDITIONAL INFORMATION

If more than one screen, show locations of each on sketch.