

MISSISSIPPI DEPARTMENT OF NATURAL RESOURCES

Bureau of Land and Water Resources

Southport Mall

P.O. Box 10631

Jackson, Mississippi 39209

WATER WELL DRILLERS LOG

JACKSON
/M 2159

4-8-86 date well completed 19 Coastwater well firm name Jackson county well located

LANDOWNER: Roy Cotton
5600 Slater Circle
Thasozouly Miss.
(mailing address) 39174

description of formations encountered	from	to
Top Soil	0	2
Red Coarse Sand + wood	2	50
Blue Clay	50	60
Red Coarse Sand + gravel	60	115
Blue Clay	115	190
Gray Coarse Sand	190	211
Gray Coarse Sand + gravel	211	216

WELL LOCATION:
sec 8 T 6 R 5
2 miles NORTH of HELENA
(distance) (direction) (nearest town)

WELL PURPOSE: home
(home, irrigation, municipal, industrial)

WELL COMPLETION DATA:

(1) diameter (inches) 2"
(2) total depth (feet) 216'
(3) static water level (feet) 39' below top of ground
(4) casing PVC, 201 (material), (depth)
2" (size) If telescope see back.
(5) screen 10 (length), 201 (depth to top)
2" (size), PVC (material)
(6) pump (HP), (yield gpm)
(type power)
(7) electric log no (yes or no)
(organization running log)
(8) how well bottom plugged backwash valve

201
10
211
well


MAY 12 1986

DRILLERS REMARKS: 5' - 2" PVC tail pipe

Department of Natural Resources
Bureau of Land & Water Resources

If well telescopes please sketch and show depths.

GROUND LEVEL

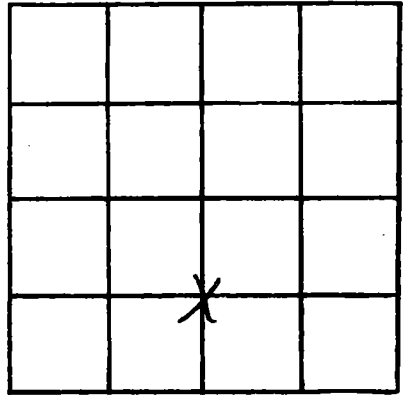

SECTION 8

Please indicate well location X.

ADDITIONAL INFORMATION

If more than one screen, show locations of each on sketch.