

Jackson
M 2161

MISSISSIPPI
BOARD OF WATER COMMISSIONERS
416 North State Street
Jackson, Mississippi 39201

WATER WELL DRILLERS LOG

5-22 1986 date well completed De Pierce Drilling Co firm name Jackson county well located

LANDOWNER: Randy Zalkert
8924 Broadus Rd.
Pascagoula Ms
(mailing address)

WELL LOCATION:
sec. 10 T. 6 N R. 5 E
4 miles South of Big Point
(distance) (direction) (nearest town)

WELL PURPOSE:
(home irrigation, municipal, industrial)

- WELL COMPLETION DATA:
- (1) diameter (inches) 2"
 - (2) total depth (feet) 296'
 - (3) static water level (feet) 15' below top of ground
 - (4) casing plastic 291' (material) (depth)
 - (5) screen 5' 296' (length) (depth to top)
0.06 plastic (size) (material)
 - (6) pump 1 (HP) 12 (yield gpm)
electric (type power)
 - (7) electric log (yes or no)
 - (8) how well bottom plugged BU


description of formations encountered	from	to
top soil	0	10
good sand	10	40
clay	40	120
good sand	120	160
clay	160	180
good sand	180	230
clay	230	280
good sand	280	296

RECEIVED
AUG 11 1986

DRILLERS REMARKS: Department of Natural Resources
Bureau of Land & Water Resources

If well telescopes please sketch and show depths.

GROUND LEVEL

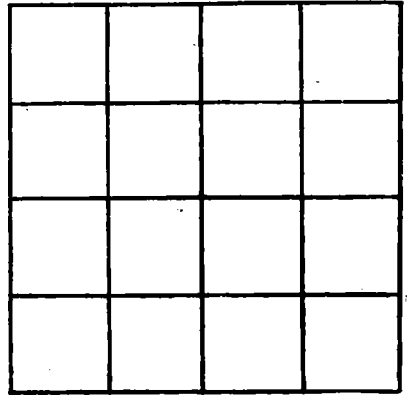

SECTION _____

Please indicate well location X.

ADDITIONAL INFORMATION

If more than one screen,
show locations of each on sketch.