

JACKSON
M 2162

MISSISSIPPI
BOARD OF WATER COMMISSIONERS
416 North State Street
Jackson, Mississippi 39201

WATER WELL DRILLERS LOG

6-30 1986 St. Pierce Drilling Co. Jackson
date well completed firm name county well located

LANDOWNER: Bobby Blake
14227 Wolf Ridge Rd
Wade, Ms
(mailing address)

description of formations encountered	from	to
top soil	0	20
clay	20	30
good sand	30	120
clay	120	150
good sand	150	175

WELL LOCATION:
sec. 13 T. 6 N. R. 5 E.
3 miles east of Pass. River
(distance) (direction) (nearest town)

WELL PURPOSE:
home, irrigation, municipal, industrial

WELL COMPLETION DATA:

(1) diameter (inches) 2"

(2) total depth (feet) 175'

(3) static water level (feet) 20 ^{below} _{above} top of ground

(4) casing plastic, 170'
(material) (depth)

0
(size) If telescope see back.

(5) screen 5, 175
(length) (depth to top)

006, plastic
(size) (material)

(6) pump 1 10
(HP) (yield gpm)

electric
(type power)

(7) electric log (yes or no)

(organization running log)

(8) how well bottom plugged BW

RECEIVED


AUG 11 1986

DRILLERS REMARKS:

Department of Natural Resources
Bureau of Land & Water Resources

If well telescopes please sketch and show depths.

GROUND LEVEL

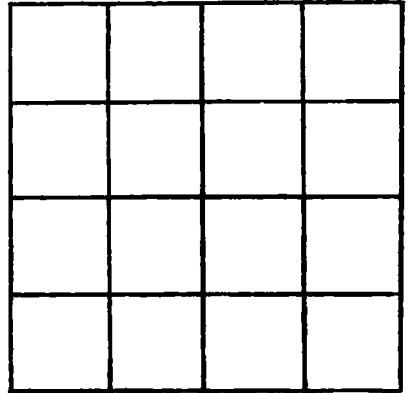

SECTION _____

Please indicate well location X.

ADDITIONAL INFORMATION

If more than one screen, show locations of each on sketch.