

JACKSON  
M 2163

MISSISSIPPI  
BOARD OF WATER COMMISSIONERS  
416 North State Street  
Jackson, Mississippi 39201

WATER WELL DRILLERS LOG

7-21 1986 Pierce Drilling Co. Jackson  
date well completed firm name county well located

LANDOWNER: Mitchell & Leg

description of formations encountered

from to

Helena Ms  
(mailing address)

Top Soil	0	10
Clay	10	20
good sand	20	50
Clay	50	70
good sand	70	85

WELL LOCATION:

sec. 5 T. 6 N. R. 5 E.  
3 miles South of Big Point  
(distance) (direction) (nearest town)

WELL PURPOSE:

(home, irrigation, municipal, industrial)

WELL COMPLETION DATA:

- (1) diameter (Inches) 2"
- (2) total depth (feet) 85'
- (3) static water level (feet) 20' (below above top of ground)
- (4) casing plastic 80' (material) (depth)
- (5) screen 5' 85' (length) (depth to top)  
006 plastic (size) (material)
- (6) pump 1 (HP) 20 (yield gpm)  
electric (type power)
- (7) electric log (yes or no)

(organization running log)

(8) how well bottom plugged Bu

DRILLERS REMARKS:


RECEIVED

AUG 11 1986

Department of Natural Resources  
Bureau of Land & Water Resources

If well telescopes please sketch and show depths.

GROUND LEVEL

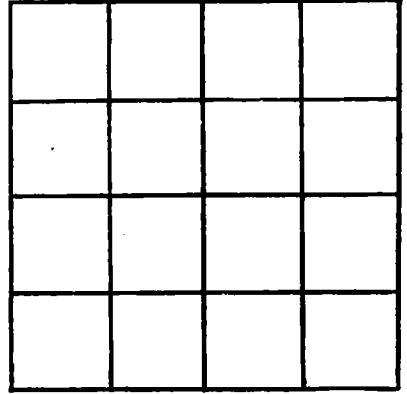

SECTION \_\_\_\_\_

Please indicate well location X.

ADDITIONAL INFORMATION

If more than one screen, show locations of each on sketch.