

JACKSON

M 2164

MISSISSIPPI BOARD OF WATER COMMISSIONERS 416 North State Street Jackson, Mississippi 39201

WATER WELL DRILLERS LOG

8-4 1986

St. Pierce Drilling Co. Jackson

date well completed

firm name

county well located

LANDOWNER: Donald Sawyer  
Cordy Rd.  
Helena, MS  
(mailing address)

description of formations encountered	from	to
top soil	0	10
clay	10	20
sand	20	50
clay	50	135
good sand	135	158

WELL LOCATION:  
sec. 27 T. 6 N R. 5 E  
6 miles south of Big Point  
(distance) (direction) (nearest town)

WELL PURPOSE:  
(home, irrigation, municipal, industrial)


- WELL COMPLETION DATA:
- (1) diameter (inches) 2"
  - (2) total depth (feet) 158'
  - (3) static water level (feet) 6' <sup>below</sup> top of ground.
  - (4) casing plastic 153' (material) (depth)
  - (5) screen 5' 158' (length) (depth to top)
  - (6) pump 1/2 (HP) 8 (yield gpm)  
electric (type power)
  - (7) electric log (yes or no)
  - (8) how well bottom plugged BU

RECORDED  
AUG 11 1986

DRILLERS REMARKS:

If well telescopes please sketch and show depths.

GROUND LEVEL

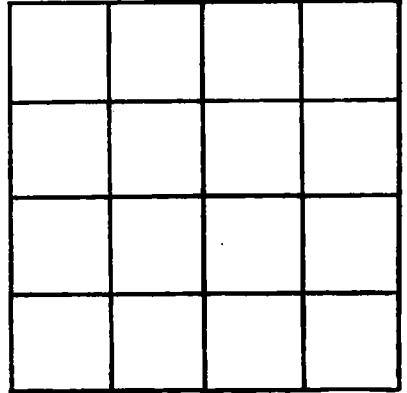

SECTION \_\_\_\_\_

Please indicate well location X.

ADDITIONAL INFORMATION

A series of horizontal lines for providing additional information.

If more than one screen, show locations of each on sketch.