

MISSISSIPPI DEPARTMENT OF NATURAL RESOURCES

Bureau of Land and Water Resources

Southport Mall

P.O. Box 10631

Jackson, Mississippi 39209

WATER WELL DRILLERS LOG

JACKSON
M2165

6-10-86 19 Coast water well Jackson
date well completed firm name county well located

LANDOWNER: Dennis Denmark

Description of formations encountered

from

to

6504 Carly Rd

Top soil 0 1

Pascagoula mo (mailing address) 39567

Brown Clay 1 28

WELL LOCATION:

sec 33 T-6 N R-5
IN miles S of HELENA
(distance) (direction) (nearest town)

White coarse sand + Gravel 28 61

WELL PURPOSE: HOME (home, irrigation, municipal, industrial)

Blue Clay 61 171

WELL COMPLETION DATA:

Gray med sand 171 183

(1) diameter (Inches) 2"

Blue Clay 183 187

(2) total depth (feet) 235'

Gray med sand 187 230

(3) static water level (feet) 22 below top of ground

Blue Clay 230 235

(4) casing PVC 220' (material) (depth)

220
10
230
well

2" (size) If telescope see back.

(5) screen 10' 220' (length) (depth to top)

2" (size) PVC (material)

(6) pump 1 (HP) 12 (yield gpm)

Elect (type power)

(7) electric log NO (yes or no)

(organization running log)

RECEIVED

AUG 20 1986

Department of Natural Resources
Bureau of Land & Water Resources


(8) how well bottom plugged: backward valve

DRILLERS REMARKS:

5 ft 2" PVC tail pipe

If well telescopes please sketch and show depths.

GROUND LEVEL

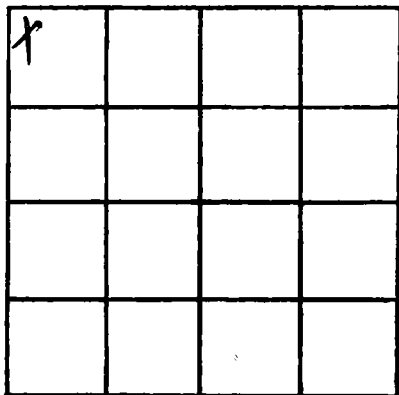

SECTION 33

Please indicate well location X.

ADDITIONAL INFORMATION

If more than one screen,
show locations of each on sketch.