

MISSISSIPPI DEPARTMENT OF NATURAL RESOURCES

Bureau of Land and Water Resources

Southport Mall

P.O. Box 10631

Jackson, Mississippi 39209

WATER WELL DRILLERS LOG

JACKSON
M 2 / 66

6-18-86 19 Coast water well Jackson
date well completed firm name county well located

LANDOWNER: Presley Curtis
Rt 1 BOX 10501
Paragould mo
(mailing address)

WELL LOCATION:
sec. 25 T. 6 N. R. 5 W.
4 miles East of Helena
(distance) (direction) (nearest town)

WELL PURPOSE: home
(home, irrigation, municipal, industrial)

WELL COMPLETION DATA:
(1) diameter (inches) 2"
(2) total depth (feet) 121'
(3) static water level (feet) 8' below top of ground.
(4) casing PVC, 136',
(material) (depth)
2"
(size) If telescope see back.
(5) screen 10', 136'
(length) (depth to top)
2", PVC
(size) (material)
(6) pump _____
(HP) (yield gpm)
(type power) _____
(7) electric log no
(yes or no)
(organization running log) _____
(8) how well bottom plugged: Backwash valve

description of formations encountered	from	to
Top soil	0	1
Red clay	1	30
Red coarse sand	30	54
Blue clay	54	100
White coarse sand	100	126
Gravel	126	151

136
10
146
well 17


RECEIVED
AUG 1 9 1986

DRILLERS REMARKS:
5'-2"-PVC
tail pipe

Department of Natural Resources
Bureau of Land and Water Resources

If well telescopes please sketch and show depths.

GROUND LEVEL

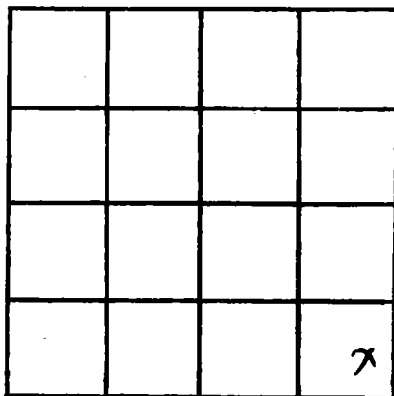

SECTION 25

Please indicate well location X.

ADDITIONAL INFORMATION

If more than one screen, show locations of each on sketch.