

MISSISSIPPI DEPARTMENT OF NATURAL RESOURCES

Bureau of Land and Water Resources

Southport Mall

P.O. Box 10631

Jackson, Mississippi 39209

WATER WELL DRILLERS LOG

JACKSON
M2167

7-3-86

19 Coast water well Jackson

date well completed

firm name

county well located

LANDOWNER: R.L. Hammons

9200 Pollocks Ferry Rd.

Pascagoula MS
(mailing address)

WELL LOCATION:

sec. 35 T. 6 N. R. 5 E.
3 miles SE of Helena
(distance) (direction) (nearest town)

WELL PURPOSE: Home
(home, irrigation, municipal, industrial)

WELL COMPLETION DATA:

- (1) diameter (inches) 2"
 - (2) total depth (feet) 200'
 - (3) static water level (feet) 30' (below top of ground)
 - (4) casing PVC 185' (material) (depth)
2" (size) If telescope see back.
 - (5) screen 10' 185' (length) (depth to top)
2" (size) PVC (material)
 - (6) pump 1/2 HP 6 (type power) (yield gpm)
 - (7) electric log NO (yes or no)
- (organization running log)

(8) how well bottom plugged backwash valve

DRILLERS REMARKS:

5'-2" PVC tailpipe

Description of formations encountered	from	to
Top Soil	0	2
Red Sand	2	4
Blue Clay	4	27
White Coarse Sand + Pea Gravel	27	73
Blue Clay	73	118
White Coarse Sand	118	134
Blue Clay	134	135
White Coarse Sand + Gravel	135	178
Blue Clay	178	181
White Coarse Sand	181	200
well 185 10 175		


RECEIVED

AUG 28 1986

Department of Natural Resources
Bureau of Land & Water Resources

If well telescopes please sketch and show depths.

GROUND LEVEL

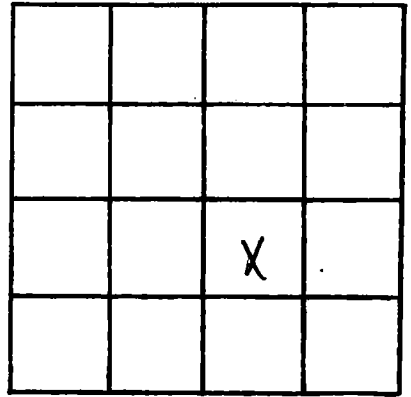

SECTION 35

Please indicate well location X.

ADDITIONAL INFORMATION

A series of horizontal lines for writing additional information.

If more than one screen, show locations of each on sketch.