

MISSISSIPPI DEPARTMENT OF NATURAL RESOURCES

Bureau of Land and Water Resources

Southport Mall

P.O. Box 10631

Jackson, Mississippi 39209

WATER WELL DRILLERS LOG

JACKSON  
M2168

7-16 1986 Coast Water Well Serv. Jackson  
date well completed firm name county well located

LANDOWNER: MARK NARON  
6429 Corda Rd  
Pascagoula ms  
(mailing address)

WELL LOCATION:  
sec 33 T 6 R 5 E  
1 miles SOUTH of HELENA  
(distance) (direction) (nearest town)

WELL PURPOSE: Home  
(home, irrigation, municipal, industrial)

WELL COMPLETION DATA:

- (1) diameter (inches) 2"
- (2) total depth (feet) 190'
- (3) static water level (feet) 25' below top of ground.
- (4) casing PVC, 175'  
(material) (depth)  
2" if telescope see back.  
(size)
- (5) screen 10', 175'  
(length) (depth to top)  
2", PVC  
(size) (material)
- (6) pump \_\_\_\_\_  
(HP) (yield gpm)  
(type power)
- (7) electric log No  
(yes or no)  
(organization running log)
- (8) how well bottom plugged, BACK WASH VALVE

description of formations encountered	from	to
<u>TOPSOIL</u>	<u>0</u>	<u>1</u>
<u>BROWN CLAY</u>	<u>1</u>	<u>14</u>
<u>WHITE COARSE SAND</u>	<u>14</u>	<u>61</u>
<u>BLUE CLAY</u>	<u>61</u>	<u>165</u>
<u>GRAY MED. SAND</u>	<u>165</u>	<u>185</u>
<u>BLUE CLAY</u>	<u>185</u>	<u>190</u>
		<u>Here</u>

RECEIVED


AUG 26 1986

Department of Natural Resources  
Bureau of Land & Water Resources

DRILLERS REMARKS: 2" x 5' PVC  
Tailpipe on bottom.

If well telescopes please sketch and show depths.

GROUND LEVEL

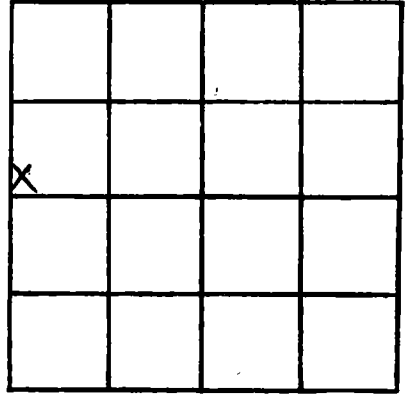

SECTION 33

Please Indicate well location X.

ADDITIONAL INFORMATION

If more than one screen,  
show locations of each on sketch.