

MISSISSIPPI DEPARTMENT OF NATURAL RESOURCES
Bureau of Land and Water Resources
 Southport Mall
 P.O. Box 10631
 Jackson, Mississippi 39209
WATER WELL DRILLERS LOG

Jackson
M 2170

8-20-86 19 Coastwater Well Jackson
 date well completed firm name county well located

LANDOWNER: V.H. Harrison
5008 Presley Rd
Pascagoula, ms.
 (mailing address)

WELL LOCATION:
 sec. 31 T. 6 N R. 5 E
3 miles NE of Escatawpa
 (distance) (direction) (nearest town)

WELL PURPOSE: home
 (home, irrigation, municipal, industrial)

WELL COMPLETION DATA:

- (1) diameter (inches) 2"
- (2) total depth (feet) 179'
- (3) static water level (feet) 45' below top of ground.
- (4) casing PVC, 163'
 (material) (depth)
2"
 (size) if telescope see back.
- (5) screen 10', 163'
 (length) (depth to top)
2", PVC
 (size) (material)
- (6) pump _____
 (HP) (yield gpm)

 (type power)
- (7) electric log no
 (yes or no)

 (organization running log)
- (8) how well bottom plugged backwash valve

description of formations encountered	from	to
Top Soil	0	2
Red Clay	2	5
Blue Clay	5	11
White Course Sand	11	79
log	79	
White Course Sand + Gravel	79	108
Blue Clay	108	162
Gray Course Sand	162	173
Blue Clay	173	178
		hole
		163
		10
		well 73


RECEIVED
 SEP 11 1986

DRILLERS REMARKS:
5 ft 2" PVC tail pipe

Department of Natural Resources
 Bureau of Land & Water Resources

If well telescopes please sketch and show depths.

GROUND LEVEL

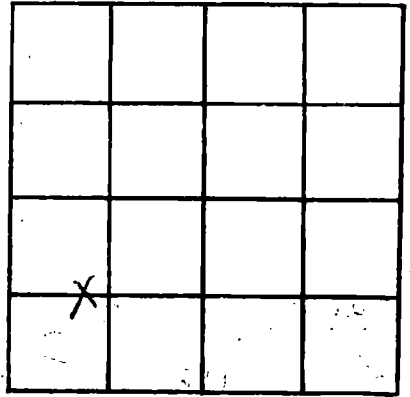

SECTION 31

Please indicate well location X:

ADDITIONAL INFORMATION

Lined area for additional information.

If more than one screen, show locations of each on sketch.