

MISSISSIPPI DEPARTMENT OF NATURAL RESOURCES

Bureau of Land and Water Resources

Southport Mall

P.O. Box 10631

Jackson, Mississippi 39209

WATER WELL DRILLERS LOG

JACKSON
M9.171

8-23-86 ¹⁹ Good water well Jackson
date well completed firm name county well located

LANDOWNER: Waymon Clegg
3725 Old Airport Rd
Pascagoula Ms 39567
(mailing address)

WELL LOCATION:
sec. 20 T. 6 N. R. 4 E.
5 1/4 miles ENE of Helena
(distance) (direction) (nearest town)

WELL PURPOSE: home
(home, irrigation, municipal, industrial)

WELL COMPLETION DATA:

- (1) diameter (inches) 2"
- (2) total depth (feet) 105 ft
- (3) static water level (feet) 5 below top of ground.
- (4) casing (material) PVC, (depth) 90 ft
2" (size) if telescope see back.
- (5) screen (length) 10 ft, (depth to top) 90 ft
2" (size), PVC (material)
- (6) pump (HP) _____ (yield gpm) _____
(type power) _____
- (7) electric log no (yes or no)
(organization running log) _____
- (8) how well bottom plugged backwash valve

| Description of formations encountered | from | to |
|---------------------------------------|------|-----|
| top soil | 0 | 1 |
| red clay | 1 | 10 |
| red coarse sand + gravel | 10 | 25 |
| clay | 25 | |
| blue clay | 25 | 71 |
| white coarse sand | 71 | 101 |
| white coarse sand + gravel | 101 | 105 |

90
10
well 00


RECEIVED
SEP 11 1986

Department of Natural Resources
Bureau of Land & Water Resources

DRILLERS REMARKS:
5 ft 2" PVC tailpipe

If well telescopes please sketch and show depths.

GROUND LEVEL

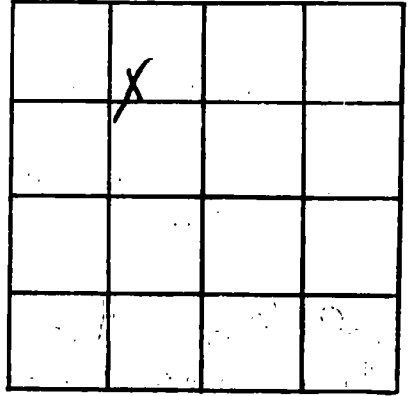

SECTION 20

Please indicate well location X.

ADDITIONAL INFORMATION

If more than one screen, show locations of each on sketch.