

MISSISSIPPI DEPARTMENT OF NATURAL RESOURCES
Bureau of Land and Water Resources

P.O. Box 10631

Jackson, Mississippi 39209

WATER WELL DRILLERS LOG

COUNTY WELL LOCATED	
Jackson	
WELL NUMBER	LOGGED
M 217	
DATE WELL COMPLETED	
1-3-87	

PERMIT NUMBER
NAME OF DRILLING FIRM
Coastwaterwell

NAME & MAILING ADDRESS OF LANDOWNER		
Ronald Carpenter		
6601 Coda Rd.		
Pascagoula mo		
WELL LOCATION:	SEC	TOWNSHIP
	32	6
		5
		W
DISTANCE	DIRECTION	NEAREST TOWN
1/2	S	Helena
OTHER LANDMARK		
WELL PURPOSE: Home, Irrigation, Municipal, Industrial, Fish Pond, etc.		
home		


PUMP DATA		
PUMP TYPE (Circle One):		
Submersible,	Turbine,	<input checked="" type="radio"/> Jet
Flowing Well, Other (Describe) _____		
POWER TYPE (Circle One):		
<input checked="" type="radio"/> Electric,	Tractor,	Diesel, Gasoline, Butane,
Other (Describe) _____		
Pump Capacity (GPM)	No. of Stages	Setting Depth
8	2	_____ FT.
PUMP TEST		
Well yielded _____ GPM with		
a drawdown of _____ ft.		
after _____ hours of pumping		

WELL DATA		
Well Depth	Casing Diameter (In.)	Casing Length (Ft.)
172 1/2'	2"	157'
Type of Casing	Hole Depth	Depth to Static Water Level
PVC	172'	22'
TYPE OF COMPLETION: (Circle One or More):		
Gravel Packed,	Underreamed,	Telescoped,
Natural Development,	Open Hole,	Other
(Describe) _____		
Top of Lap Pipe or Reduction in Casing		
FEET	IF TELESCOPED OR MORE THAN ONE SCREEN: USE BACK PAGE	

LOG DATA	
TYPE OF LOG RUN (Circle One):	
Electric, Gamma Ray, Density, Sonic, Neutron,	<input checked="" type="radio"/> No Log Run,
Other (Describe) _____	
Name of Organization Running Log	

SCREEN DATA		
Diameter - Inches	Length - Feet	Slot Size - Inches
2"	10'	.008
Screen Type	Depth to Bottom - Feet	
PVC	167'	


GEOLOGIC DATA (Office Use Only)			
Surface Elev.	Geologic Unit	Unit Thickness	Depth to Top
Subs. SWL	Date	Analysis	Aquifer Test
Driller's Remarks			

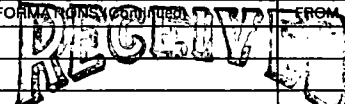DESCRIPTION OF FORMATIONS ENCOUNTERED	FROM	TO	FORMATIONS ENCOUNTERED	FROM	TO
Top Soil	0	2	 MAY 21 1987 Department of Natural Resources Bureau of Land & Water Resources		
White Clay	2	9			
Blue Clay	9	22			
White coarse sand	22	60			
Blue Clay	60	140			
Gray med sand	140	172			

IF MORE SPACE IS NEEDED, USE BACK

If well telescopes please
sketch and show depths.

GROUND LEVEL

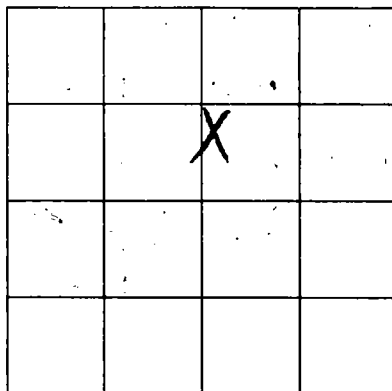

SECTION 32

Please indicate well location X:

ADDITIONAL INFORMATION

If more than one screen,
show location of each on sketch.