

**MISSISSIPPI DEPARTMENT OF NATURAL RESOURCES**  
Bureau of Land and Water Resources

P.O. Box 10631  
Jackson, Mississippi 39209  
**WATER WELL DRILLERS LOG**

COUNTY WELL LOCATED <b>Jackson</b>	
WELL NUMBER <b>M 2179</b>	CODED
DATE WELL COMPLETED <b>3-4-87</b>	

PERMIT NUMBER
NAME OF DRILLING FIRM <b>Coast water well Service Inc</b>

NAME & MAILING ADDRESS OF LANDOWNER <b>James Rouse</b> <b>PO Box 1125</b> <b>Escatawpa MS 39552</b>			
WELL LOCATION:	SEC	TOWNSHIP	RANGE
	<b>30</b>	<b>6 S</b>	<b>5 W</b>
DISTANCE	DIRECTION	NEAREST TOWN	
<b>1 1/2</b> Miles	<b>SW</b>	of <b>HELENA</b>	
OTHER LANDMARK			
WELL PURPOSE: Home, Irrigation, Municipal, Industrial, Fish Pond, etc. <b>Home</b>			

<b>PUMP DATA</b>		
PUMP TYPE (Circle One): Submersible, Turbine, Jet, Flowing Well, Other (Describe) _____		
POWER TYPE (Circle One): Electric, Tractor, Diesel, Gasoline, Butane, Other (Describe) _____		
Pump Capacity (GPM)	No. of Stages	Setting Depth <b>FT.</b>
PUMP TEST		
Well yielded _____ GPM with a drawdown of _____ ft. after _____ hours of pumping		

<b>WELL DATA</b>		
Well Depth <b>60'</b>	Casing Diameter (In.) <b>2"</b>	Casing Length (Ft.) <b>45'</b>
Type of Casing <b>PVC</b>	Hole Depth <b>60'</b>	Depth to Static Water Level <b>1 ft.</b>
TYPE OF COMPLETION: (Circle One or More): <input checked="" type="checkbox"/> Gravel Packed, <input type="checkbox"/> Underreamed, <input type="checkbox"/> Telescoped, <input checked="" type="checkbox"/> Natural Development, <input type="checkbox"/> Open Hole, <input type="checkbox"/> Other (Describe) _____		
Top of Lap Pipe or Reduction in Casing <b>FEET</b> IF TELESCOPED OR MORE THAN ONE SCREEN: USE BACK PAGE		

<b>LOG DATA</b>	
TYPE OF LOG RUN (Circle One): Electric, Gamma Ray, Density, Sonic, <input checked="" type="checkbox"/> Neutron, Other (Describe) _____	
Name of Organization Running Log	

<b>SCREEN DATA</b>		
Diameter - Inches <b>2"</b>	Length - Feet <b>10'</b>	Slot Size - Inches <b>.008</b>
Screen Type <b>PVC</b>		Depth to Bottom - Feet <b>55'</b>

<b>GEOLOGIC DATA (Office Use Only)</b>			
Surface Elev.	Geologic Unit	Unit Thickness	Depth to Top
Subs. SWL	Date	Analysis	Aquifer Test
Driller's Remarks			

DESCRIPTION OF FORMATIONS ENCOUNTERED	FROM	TO
<b>Top Soil</b>	<b>0</b>	<b>2</b>
<b>Brick Clay</b>	<b>2</b>	<b>14</b>
<b>White Coarse Sand</b>	<b>14</b>	<b>60</b>

# RECEIVED


SEP 21 1987

**Department of Natural Resources**  
**Bureau of Land & Water Resources**

IF MORE SPACE IS NEEDED, USE BACK

If well telescopes please sketch and show depths.

GROUND LEVEL

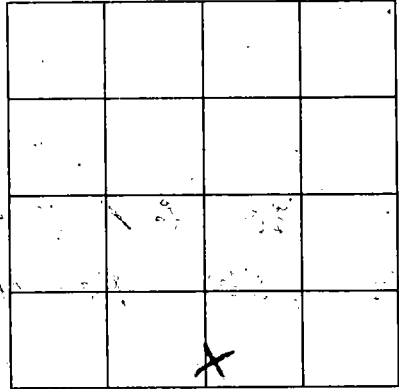

SECTION 30

Please indicate well location X.

ADDITIONAL INFORMATION



*[Faint, illegible text]*

If more than one screen,  
show location of each on sketch.