

MISSISSIPPI DEPARTMENT OF NATURAL RESOURCES
Bureau of Land and Water Resources

P.O. Box 10631

Jackson, Mississippi 39209

WATER WELL DRILLERS LOG

COUNTY WELL LOCATED Jackson ?
WELL NUMBER (PRODED) M2180
DATE WELL COMPLETED 3-6-87

PERMIT NUMBER
NAME OF DRILLING FIRM Coast water well Service, Inc.

NAME & MAILING ADDRESS OF LANDOWNER Richard Greene		
9125 Greeris Rd.		
Pascagoula MS 39501		
WELL LOCATION: SEC	TOWNSHIP	RANGE
17	6	5
DISTANCE DIRECTION NEAREST TOWN 2 1/2 Miles N of Helena		
OTHER LANDMARK		
WELL PURPOSE: Home, Irrigation, Municipal, Industrial, Fish Pond, etc. home.		

PUMP DATA		
PUMP TYPE (Circle One): Submersible, Turbine, Jet Flowing Well, Other (Describe) _____		
POWER TYPE (Circle One): Electric, Tractor , Diesel, Gasoline, Butane, Other (Describe) _____		
Pump Capacity (GPM) 12	No. of Stages 2	Setting Depth - FT.
PUMP TEST Well yielded _____ GPM with a drawdown of _____ ft. after _____ hours of pumping		

WELL DATA		
Well Depth 225'	Casing Diameter (In.) 2"	Casing Length (Ft.) 210'
Type of Casing PVC	Hole Depth 225'	Depth to Static Water Level 20'
TYPE OF COMPLETION: (Circle One or More): Gravel Packed , Underreamed, Telescoped, Natural Development , Open Hole, Other		
Top of Lap Pipe or Reduction in Casing FEET IF TELESCOPED OR MORE THAN ONE SCREEN: USE BACK PAGE		

LOG DATA	
TYPE OF LOG RUN (Circle One): No Log Run , Electric, Gamma Ray, Density, Sonic, Neutron, Other (Describe) _____	
Name of Organization Running Log	

SCREEN DATA		
Diameter - Inches 2"	Length - Feet 10'	Slot Size - Inches .008
Screen Type PVC		Depth to Bottom - Feet 220'

GEOLOGIC DATA (Office Use Only)			
Surface Elev.	Geologic Unit	Unit Thickness	Depth to Top
Subs. SWL	Date	Analysis	Aquifer Test


Driller's Remarks

DESCRIPTION OF FORMATIONS ENCOUNTERED	FROM	TO
Top Soil	0	2
Brown Clay	2	5
Red Coarse Sand	5	28
Blue Clay	28	50
White Coarse Sand	50	76
Blue Clay	76	91
Gray Coarse Sand	91	194
Blue Clay	194	196
Gray Coarse Sand	196	222
Blue Clay	222	225

FORMATIONS (Continued)	
FROM	TO
MAY 21 1987	
Department of Natural Resources	
Bureau of Land & Water Resources	
IF MORE SPACE IS NEEDED, USE BACK	

If well telescopes please sketch and show depths.

GROUND LEVEL

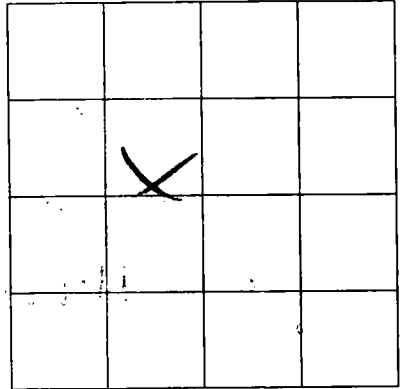

17

SECTION _____

Please indicate well location X.

ADDITIONAL INFORMATION

If more than one screen,
show location of each on sketch.