


**MISSISSIPPI DEPARTMENT OF NATURAL RESOURCES**  
**Bureau of Land and Water Resources**  
 Southport Mall  
 P.O. Box 10631  
 Jackson, Mississippi 39209  
**WATER WELL DRILLERS LOG**

**JACKSON**  
**M 2185**

5-28 1987 Poize Drilling Co. Jackson  
 date well completed                      firm name                      county well located

LANDOWNER: <u>Rev. Coleman</u> <u>Cody Rd.</u>	description of formations encountered	from	to
<u>Pascagoula Ms</u> (mailing address)	<u>top soil</u>	<u>0</u>	<u>10</u>
<b>WELL LOCATION:</b>	<u>clay</u>	<u>10</u>	<u>40</u>
sec. <u>33</u> T. <u>6</u> N. R. <u>5</u> E.	<u>good sand</u>	<u>40</u>	<u>60</u>
<u>2</u> miles <u>South</u> of <u>Helena</u>	<u>clay</u>	<u>60</u>	<u>125</u>
(distance) (direction) (nearest town)	<u>good sand</u>	<u>125</u>	<u>165</u>
<b>WELL PURPOSE:</b>			
<u>(home)</u> irrigation, municipal, industrial			
<b>WELL COMPLETION DATA:</b>			
(1) diameter (inches) <u>2"</u>			
(2) total depth (feet) <u>165'</u>			
(3) static water level (feet) <u>20</u> <u>below</u> top of ground.			
(4) casing <u>plastic, 160'</u> (material) (depth)			
<u>0</u> if telescope see back. (size)			
(5) screen <u>5'</u> , <u>165'</u> (length) (depth to top)			
<u>006, plastic</u> (size) (material)			
(6) pump <u>1</u> <u>10</u> (HP) (yield gpm)			
<u>electric</u> (type power)			
(7) electric log <u>(yes or no)</u>			
(organization running log)			
(8) how well bottom plugged <u>BW</u>			
<b>DRILLERS REMARKS:</b>			

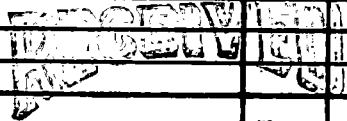


SEP 10 1987

Department of Natural Resources  
 Bureau of Land & Water Resources

If well telescopes please sketch and show depths.

GROUND LEVEL

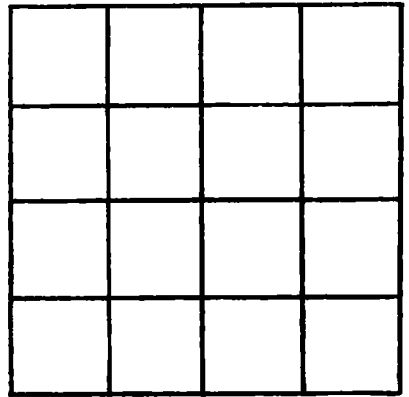

SECTION \_\_\_\_\_

Please indicate well location X.

ADDITIONAL INFORMATION

If more than one screen, show locations of each on sketch.