

MISSISSIPPI DEPARTMENT OF NATURAL RESOURCES

Bureau of Land and Water Resources

P.O. Box 10631

Jackson, Mississippi 39209

WATER WELL DRILLERS LOG

COUNTY WELL LOCATED Jackson	
WELL NUMBER M 2181	CODED
DATE WELL COMPLETED 3-12-87	

PERMIT NUMBER
NAME OF DRILLING FIRM Coast water well service

NAME & MAILING ADDRESS OF LANDOWNER Carl Walker			
4826 Chico St.			
Passapatanz ms.			
WELL LOCATION:	SEC	TOWNSHIP	RANGE
	10	6	5 (W)
DISTANCE	DIRECTION	NEAREST TOWN	
6 1/2 Miles	NE	of Mass Point	
OTHER LANDMARK			
WELL PURPOSE: Home, Irrigation, Municipal, Industrial, Fish Pond, etc. home			

PUMP DATA		
PUMP TYPE (Circle One): Submersible, Turbine, Jet, Flowing Well, Other (Describe) _____		
POWER TYPE (Circle One): Electric, Tractor, Diesel, Gasoline, Butane, Other (Describe) _____		
Pump Capacity (GPM)	No. of Stages	Setting Depth FT.
PUMP TEST		
Well yielded _____ GPM with a drawdown of _____ ft. after _____ hours of pumping		

WELL DATA		
Well Depth 100	Casing Diameter (In.) 2"	Casing Length (Ft.) 85'
Type of Casing PVC	Hole Depth 100	Depth to Static Water Level 1'
TYPE OF COMPLETION: (Circle One or More): Gravel Packed , Underreamed, Telescoped, Natural Development , Open Hole, Other		
Top of Lap Pipe or Reduction in Casing FEET IF TELESKOPED OR MORE THAN ONE SCREEN: USE BACK PAGE		

LOG DATA	
TYPE OF LOG RUN (Circle One): Electric, Gamma Ray, Density, Sonic, Neutron, Other (Describe) _____	
Name of Organization Running Log No Log Run	

SCREEN DATA		
Diameter - Inches 2"	Length - Feet 10'	Slot Size - Inches 000
Screen Type PVC	Depth to Bottom - Feet 95'	

GEOLOGIC DATA (Office Use Only)			
Surface Elev.	Geologic Unit	Unit Thickness	Depth to Top
Subs. SWL	Date	Analysis	Aquifer Test

Driller's Remarks

DESCRIPTION OF FORMATIONS ENCOUNTERED	FROM	TO
Top Soil	0	2
Brown Clay	2	15
White Coarse Sand	15	45
Blue Clay	45	55
White Coarse Sand	55	100

FORMATIONS (Continued)		FROM	TO
RECEIVED			
SEP 21 1987			
Department of Natural Resources Bureau of Land & Water Resources			
IF MORE SPACE IS NEEDED, USE BACK			

If well telescopes please sketch and show depths.


GROUND LEVEL

		X	

SECTION 10

Please indicate well location X.

ADDITIONAL INFORMATION

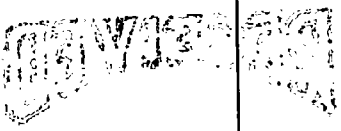

If more than one screen, show location of each on sketch.