

add-loc pump
MISSISSIPPI DEPARTMENT OF NATURAL RESOURCES
 Bureau of Land and Water Resources

P.O. Box 10631
 Jackson, Mississippi 39209
WATER WELL DRILLERS LOG

COUNTY WELL LOCATED Jackson	
WELL NUMBER M 2198	CODED
DATE WELL COMPLETED 9-12-87	

PERMIT NUMBER
NAME OF DRILLING FIRM Coastwater Well Service

NAME & MAILING ADDRESS OF LANDOWNER Jon Hamil		
9409 Ship Rock Rd		
Pascagoula MS		
WELL LOCATION: SEC	TOWNSHIP	RANGE
33	6 S	5 E
DISTANCE	DIRECTION	NEAREST TOWN
2 Miles	SE	Helena
OTHER LANDMARK		
WELL PURPOSE: Home, Irrigation, Municipal, Industrial, Fish Pond, etc. home		

PUMP DATA		
PUMP TYPE (Circle One): Submersible, Turbine, Jet , Flowing Well, Other (Describe) _____		
POWER TYPE (Circle One): Electric , Tractor, Diesel, Gasoline, Butane, Other (Describe) _____		
Pump Capacity (GPM) 8	No. of Stages 1	Setting Depth - FT.
PUMP TEST Well yielded _____ GPM with a drawdown of _____ ft. after _____ hours of pumping		


WELL DATA		
Well Depth 90'	Casing Diameter (In.) 2"	Casing Length (Ft.) 80'
Type of Casing Pvc	Hole Depth 90'	Depth to Static Water Level 12'
TYPE OF COMPLETION: (Circle One or More): Natural Development , Gravel Packed, Underreamed, Telescoped, Open Hole, Other (Describe) _____		
Top of Lap Pipe or Reduction in Casing FEET IF TELESCOPED OR MORE THAN ONE SCREEN: USE BACK PAGE		

LOG DATA	
TYPE OF LOG RUN (Circle One): Electric, Gamma Ray, Density, Sonic, No Log Run , Neutron, Other (Describe) _____	
Name of Organization Running Log	

SCREEN DATA		
Diameter - Inches 2"	Length - Feet 10'	Slot Size - Inches 008
Screen Type Pvc	Depth to Bottom - Feet 90'	

GEOLOGIC DATA (Office Use Only)			
Surface Elev.	Geologic Unit	Unit Thickness	Depth to Top
Subs. SWL	Date	Analysis	Aquifer Test
Driller's Remarks			

DESCRIPTION OF FORMATIONS ENCOUNTERED	FROM	TO
Top Soil	0	2
Brown Clay	2	16
White Clay	16	60
Sand + Pla	-	-
Gravel	-	-
Blue Clay	60	90
Gray Med Sand	62	90




MAY 24 1988

Department of Natural Resources
Bureau of Land & Water Resources

IF MORE SPACE IS NEEDED, USE BACK

If well telescopes please sketch and show depths.

GROUND LEVEL

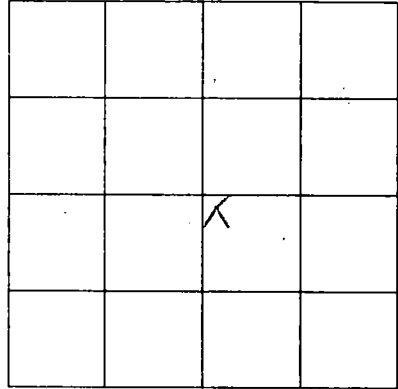

SECTION 33

Please indicate well location X.

ADDITIONAL INFORMATION

If more than one screen,
show location of each on sketch.