

MISSISSIPPI DEPARTMENT OF NATURAL RESOURCES
Bureau of Land and Water Resources

P.O. Box 10631
Jackson, Mississippi 39209
WATER WELL DRILLERS LOG

COUNTY WELL LOCATED JACKSON	
WELL NUMBER M 2194	CODED
DATE WELL COMPLETED 4-13-88	

PERMIT NUMBER
NAME OF DRILLING FIRM Coast Water
WELL SERVICE

NAME & MAILING ADDRESS OF LANDOWNER LYNN PRESLEY			
10400 Goods Mill Lake			
Pascagoula MS			
WELL LOCATION:	SEC	TOWNSHIP	RANGE
	31	6	4
		N	E
DISTANCE	DIRECTION	NEAREST TOWN	
1 Miles	S	FRANKLIN CREEK	
OTHER LANDMARK			
WELL PURPOSE: Home, Irrigation, Municipal, Industrial, Fish Pond, etc. House			

PUMP DATA		
PUMP TYPE (Circle One): Submersible, Turbine, Jet Flowing Well, Other (Describe) _____		
POWER TYPE (Circle One): Electric Tractor, Diesel, Gasoline, Butane, Other (Describe) _____		
Pump Capacity (GPM) 20'	No. of Stages 1	Setting Depth - FT.
PUMP TEST		
Well yielded _____ GPM with a drawdown of _____ ft. after _____ hours of pumping		

WELL DATA		
Well Depth 175' 168'	Casing Diameter (In.) 2"	Casing Length (Ft.) 158'
Type of Casing PVC	Hole Depth 172'	Depth to Static Water Level 7'
TYPE OF COMPLETION: (Circle One or More): Gravel Packed Underreamed, Telescoped, Natural Development Open Hole, Other		
Top of Lap Pipe or Reduction in Casing		
FEET	IF TELESCOPED OR MORE THAN ONE SCREEN: USE BACK PAGE	

LOG DATA	
TYPE OF LOG RUN (Circle One): Electric, Gamma Ray, Density, Sonic, No Log Run , Other (Describe) _____	
Name of Organization Running Log	

SCREEN DATA		
Diameter - Inches 2"	Length - Feet 10'	Slot Size - Inches .008
Screen Type PVC	Depth to Bottom - Feet 168'	

GEOLOGIC DATA (Office Use Only)			
Surface Elev.	Geologic Unit	Unit Thickness	Depth to Top
Subs. SWL	Date	Analysis	Aquifer Test
Driller's Remarks			


DESCRIPTION OF FORMATIONS ENCOUNTERED	FROM	TO	FORMATIIONS (Continued)	
			FROM	TO
RED CLAY	0	5		
WHITE COARSE SAND	5	42		
BLUE CLAY	42	44		
WHITE COARSE SAND	44	95		
BLUE CLAY	95	115		
WHITE COARSE SAND	115	172		

RECEIVED
MAY 21 1988

IF MORE SPACE IS NEEDED, USE BACK

If well telescopes please sketch and show depths.

GROUND LEVEL

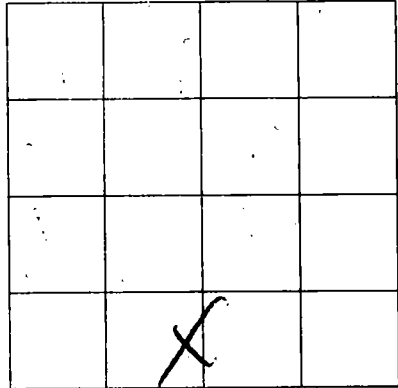

SECTION 31

Please indicate well location X.

ADDITIONAL INFORMATION

If more than one screen,
show location of each on sketch.