

MISSISSIPPI DEPARTMENT OF NATURAL RESOURCES

Bureau of Land and Water Resources

Southport Mall

P.O. Box 10631

Jackson, Mississippi 39209

WATER WELL DRILLERS LOG

Jackson
M 2196

7/15/88
date well completed

19 Golden Well Dr.
firm name

Jackson
county well located

LANDOWNER: The Ewing
Bush Hill Rd
Pascagoula ms
(mailing address)

description of formations encountered from to

sand 0 25

WELL LOCATION:

sec. 11 T. 6 N. R. 4 E.
15 miles E of Pin
(distance) (direction) (nearest town)

WELL PURPOSE: Domestic
(home, irrigation, municipal, industrial)

WELL COMPLETION DATA:

- (1) diameter (inches) 2"
- (2) total depth (feet) 25'
- (3) static water level (feet) 5 ^{below} above top of ground.
- (4) casing PVC, 20
(material) (depth)
2" If telescope see back.
(size)
- (5) screen 5, 20
(length) (depth to top)
2, PVC
(size) (material)
- (6) pump 1/2, 8
(HP) (yield gpm)
PVC
(type power)
- (7) electric log N
(yes or no)

RECEIVED

AUG 04 1988

Department of Natural Resources
Bureau of Land & Water Resources


(organization running log)

(8) how well bottom plugged BWD

DRILLERS REMARKS:

If well telescopes please sketch and show depths.

GROUND LEVEL

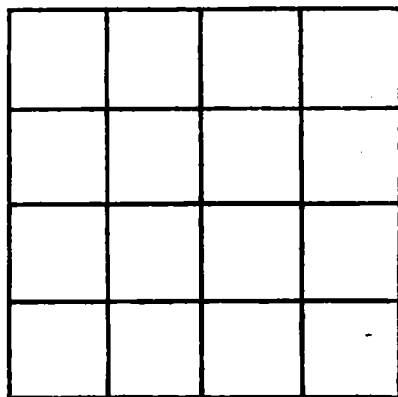

SECTION _____

Please indicate well location X.

ADDITIONAL INFORMATION

If more than one screen,
show locations of each on sketch.