

**MISSISSIPPI DEPARTMENT OF NATURAL RESOURCES**  
Bureau of Land and Water Resources

P.O. Box 10631  
Jackson, Mississippi 39209  
**WATER WELL DRILLERS LOG**

COUNTY WELL LOCATED <i>Jackson</i>	
WELL NUMBER <i>M 2208</i>	CODED
DATE WELL COMPLETED <i>8-1-89</i>	

PERMIT NUMBER
NAME OF DRILLING FIRM <i>Pierce Drilling</i>

NAME & MAILING ADDRESS OF LANDOWNER <i>John Marie</i>		
<i>12413 Jorts Lake Rd.</i>		
<i>Pascagoula, Ms</i>		
WELL LOCATION: SEC	TOWNSHIP	RANGE
<i>18</i>	<i>6</i>	<i>4</i>
DISTANCE DIRECTION NEAREST TOWN <i>1</i> Miles <i>West</i> of <i>Mobile Colina</i>		
OTHER LANDMARK		
WELL PURPOSE: <input checked="" type="checkbox"/> Home, <input type="checkbox"/> Irrigation, <input type="checkbox"/> Municipal, <input type="checkbox"/> Industrial, <input type="checkbox"/> Fish Pond, etc.		

PUMP DATA		
PUMP TYPE (Circle One): Submersible, Turbine, <input checked="" type="radio"/> Jet, Flowing Well, Other (Describe) _____		
POWER TYPE (Circle One): <input checked="" type="radio"/> Electric, <input type="radio"/> Tractor, <input type="radio"/> Diesel, <input type="radio"/> Gasoline, <input type="radio"/> Butane, Other (Describe) _____		
Pump Capacity (GPM) <i>10</i>	No. of Stages <i>2</i>	Setting Depth <i>40</i> FT.
PUMP TEST		
Well yielded <i>10</i> GPM with a drawdown of <i>5</i> ft. after <i>1</i> hours of pumping		

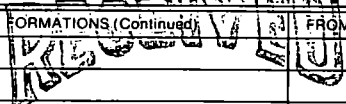
WELL DATA		
Well Depth <i>45'</i>	Casing Diameter (In.) <i>2"</i>	Casing Length (Ft.) <i>40'</i>
Type of Casing <i>Plastic</i>	Hole Depth <i>45'</i>	Depth to Static Water Level <i>20'</i>
TYPE OF COMPLETION: (Circle One or More): <input checked="" type="checkbox"/> Gravel Packed, <input type="checkbox"/> Underreamed, <input type="checkbox"/> Telescoped, <input checked="" type="checkbox"/> Natural Development, <input type="checkbox"/> Open Hole, <input type="checkbox"/> Other		
Top of Lap Pipe or Reduction in Casing		
FEET	IF TELESCOPED OR MORE THAN ONE SCREEN: USE BACK PAGE	

LOG DATA	
TYPE OF LOG RUN (Circle One): Electric, Gamma Ray, Density, Sonic, Neutron, Other (Describe) _____	
Name of Organization Running Log	

SCREEN DATA		
Diameter - Inches <i>2"</i>	Length - Feet <i>5'</i>	Slot Size - Inches <i>006</i>
Screen Type <i>Plastic</i>	Depth to Bottom - Feet <i>45'</i>	

GEOLOGIC DATA (Office Use Only)			
Surface Elev.	Geologic Unit	Unit Thickness	Depth to Top
Subs. SWL	Date	Analysis	Aquifer Test
Driller's Remarks			

DESCRIPTION OF FORMATIONS ENCOUNTERED	FROM	TO
<i>Top soil</i>	<i>0</i>	<i>10</i>
<i>Clay</i>	<i>10</i>	<i>25</i>
<i>Good Sand</i>	<i>25</i>	<i>45</i>

FORMATIONS (Continued)		FROM	TO
 OCT 24 1989 Department of Natural Resources Bureau of Land & Water Resources			
IF MORE SPACE IS NEEDED, USE BACK			

If well telescopes please  
sketch and show depths.

GROUND LEVEL


SECTION \_\_\_\_\_

Please indicate well location X.

ADDITIONAL INFORMATION

If more than one screen,  
show location of each on sketch.