

**MISSISSIPPI DEPARTMENT OF NATURAL RESOURCES**  
Bureau of Land and Water Resources

P.O. Box 10631  
Jackson, Mississippi 39209  
**WATER WELL DRILLERS LOG**

COUNTY WELL LOCATED  
*Jackson*

WELL NUMBER CODED  
*M 2210*

DATE WELL COMPLETED  
*1-10-89*

PERMIT NUMBER

NAME OF DRILLING FIRM  
*Coast Water Well Service*

NAME & MAILING ADDRESS OF LANDOWNER  
*Denise Lewis*  
*13017 Ants Lake Rd.*  
*Pascagoula, Ms. 39567*

WELL LOCATION: SEC. TOWNSHIP RANGE  
*18 6 S 4 E*

DISTANCE DIRECTION NEAREST TOWN  
*6 Miles N of Pecan*

OTHER LANDMARK

WELL PURPOSE: Home, Irrigation, Municipal, Industrial, Fish Pond, etc.  
*home*

**PUMP DATA**

PUMP TYPE (Circle One):  
Submersible, Turbine, Jet Flowing Well,  
Other (Describe) \_\_\_\_\_

POWER TYPE (Circle One):  
Electric, Tractor, Diesel, Gasoline, Butane,  
Other (Describe) \_\_\_\_\_ H/P \_\_\_\_\_

Pump Capacity (GPM) No. of Stages Setting Depth  
*15 1* \_\_\_\_\_ FT.

PUMP TEST

Well yielded \_\_\_\_\_ GPM with  
a drawdown of \_\_\_\_\_ ft.  
after \_\_\_\_\_ hours of pumping

**WELL DATA**

Well Depth <i>215'</i>	Casing Diameter (In.) <i>2"</i>	Casing Length (Ft.) <i>200'</i>
Type of Casing <i>PVC</i>	Hole Depth <i>215'</i>	Depth to Static Water Level <i>Flow</i>

TYPE OF COMPLETION: (Circle One or More):  
Natural Development, Gravel Packed, Underreamed, Telescoped,  
Open Hole, Other (Describe) \_\_\_\_\_

Top of Lap Pipe or Reduction in Casing

FEET IF TELESCOPED OR MORE THAN ONE SCREEN: USE BACK PAGE

**LOG DATA**

TYPE OF LOG RUN (Circle One):  
Electric, Gamma Ray, Density, Sonic, Neutron, No Log Run,  
Other (Describe) \_\_\_\_\_

Name of Organization Running Log

**SCREEN DATA**

Diameter - Inches <i>2"</i>	Length - Feet <i>10'</i>	Slot Size - Inches <i>.008</i>
Screen Type <i>PVC</i>	Depth to Bottom - Feet <i>210'</i>	

**GEOLOGIC DATA (Office Use Only)**

Surface Elev.	Geologic Unit	Unit Thickness	Depth to Top
Subs. SWL	Date	Analysis	Aquifer Test

Driller's Remarks

**RECEIVED**


*NOV 20 1989*

DESCRIPTION OF FORMATIONS ENCOUNTERED	FROM	TO	FORMATIONS (Continued)	FROM	TO
<i>Top Soil</i>	<i>0</i>	<i>2</i>	<i>Department of Natural Resources</i>		
<i>Red Clay</i>	<i>2</i>	<i>10</i>	<i>Bureau of Land &amp; Water</i>		
<i>White med Sand</i>	<i>10</i>	<i>28</i>			
<i>Red Clay</i>					
<i>Sand &amp; Gravel</i>	<i>28</i>	<i>80</i>			
<i>Blue Clay (W)</i>					
<i>Stratified Sand</i>	<i>80</i>	<i>107</i>			
<i>Blue Clay</i>	<i>107</i>	<i>197</i>			
<i>Gray med Sand</i>	<i>197</i>	<i>212</i>			
<i>Blue Clay</i>	<i>212</i>	<i>215</i>			

IF MORE SPACE IS NEEDED, USE BACK

If well telescopes please sketch and show depths.

GROUND LEVEL

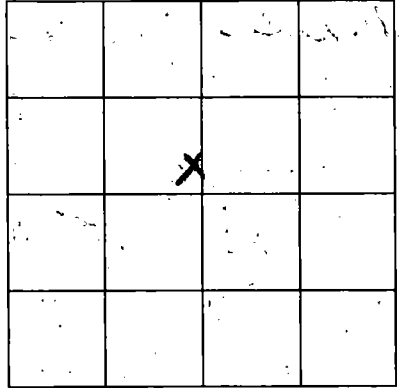

SECTION

18

Please indicate well location X.

ADDITIONAL INFORMATION

If more than one screen,  
show location of each on sketch.