

Jackson  
M 2215

MISSISSIPPI DEPARTMENT OF NATURAL RESOURCES  
Bureau of Land and Water Resources  
Southport Mall  
P.O. Box 10631  
Jackson, Mississippi 39209  
WATER WELL DRILLERS LOG

12-5-89 date well completed      Southern water well Jackson firm name      county well located


LANDOWNER:	description of formations encountered	from	to
<u>Gene Sarraw</u> <u>1112 Lake Rd. Bogalusa</u> (mailing address)			
<b>WELL LOCATION:</b>			
sec. <u>32</u> T <u>6</u> N R <u>4</u> E			
<u>10</u> miles <u>E</u> of <u>Madison</u>			
(distance) (direction) (nearest town)			
<b>WELL PURPOSE:</b> <u>None</u> (home, irrigation, municipal, industrial)			
<b>WELL COMPLETION DATA:</b>			
(1) diameter (inches) <u>2"</u>			
(2) total depth (feet) <u>135'</u>			
(3) static water level (feet) <u>8</u> <u>below</u> above top of ground.			
(4) casing <u>PVC</u> <u>130'</u> (material) (depth)			
_____ if telescope see back. (size)			
(5) screen <u>5'</u> <u>130'</u> (length) (depth to top)			
<u>2"</u> <u>PVC</u> (size) (material)			
(6) pump <u>1</u> <u>12</u> (HP) (yield gpm)			
<u>AC</u> (type power)			
(7) electric log <u>no</u> (yes or no)			
_____ (organization running log)			
(8) how well bottom plugged <u>good</u>			
<b>DRILLERS REMARKS:</b>			

RECEIVED  
DEC 13 1989

Department of Natural Resources  
Bureau of Land & Water Resources

If well telescopes please sketch and show depths.

GROUND LEVEL

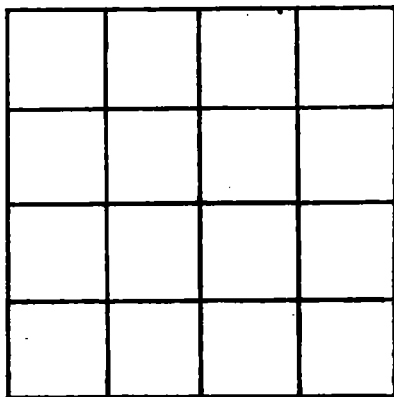

SECTION \_\_\_\_\_

Please indicate well location X.

ADDITIONAL INFORMATION

If more than one screen, show locations of each on sketch.