

MISSISSIPPI DEPARTMENT OF NATURAL RESOURCES

Bureau of Land and Water Resources

Southport Mall

P.O. Box 10631

Jackson, Mississippi 39209

WATER WELL DRILLERS LOG

JACKSON  
N 2216

10-19-89  
date well completed

Southern Water Well  
firm name

Jackson  
county well located

LANDOWNER:	description of formations encountered	from	to
Joe Jones July 613 Reg Point (mailing address)			
WELL LOCATION: sec. <u>4</u> T <u>6</u> N R <u>5</u> E <u>7</u> miles <u>S</u> of <u>Hurley</u> (distance) (direction) (nearest town)			
WELL PURPOSE: <u>None</u> (home, irrigation, municipal, industrial)			
WELL COMPLETION DATA:			
(1) diameter (inches) <u>2"</u>			
(2) total depth (feet) <u>45'</u>			
(3) static water level (feet) <u>12</u> <sup>below</sup> <sub>above</sub> top of ground.			
(4) casing <u>PVC</u> , <u>40'</u> (material) (depth)			
(size) If telescope see back.			
(5) screen <u>5'</u> , <u>40'</u> (length) (depth to top)			
<u>2"</u> , <u>PVC</u> (size) (material)			
(6) pump <u>None</u> (HP) (yield gpm)			
(type power)			
(7) electric log _____ (yes or no)			
(organization running log)			
(8) how well bottom plugged <u>BAW</u>			


RECEIVED  
MISSISSIPPI  
DEC 18 1989

Department of Natural Resources  
Bureau of Land & Water Resources

DRILLERS REMARKS:

If well telescopes please sketch and show depths.

GROUND LEVEL

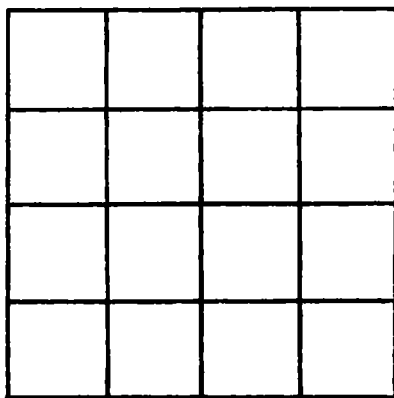

SECTION \_\_\_\_\_

Please indicate well location X.

ADDITIONAL INFORMATION

If more than one screen, show locations of each on sketch.