

MISSISSIPPI DEPARTMENT OF NATURAL RESOURCES  
 Bureau of Land and Water Resources  
 Southport Mall  
 P.O. Box 10631  
 Jackson, Mississippi 39209  
**WATER WELL DRILLERS LOG**

**RECEIVED**

MAY 9 1990

Jackson  
M 2290

3-13/90 19 Southern W/Water Jackson  
 date well completed firm name county well located

LANDOWNER: M. Dunn  
Astar St  
Helena  
 (mailing address)

description of formations encountered	from	to
	<u>clay sand</u>	<u>0</u> <u>15</u>

WELL LOCATION:  
 sec. 34 T. 6 N R. 5 E  
7 miles NE Meridian  
 (distance) (direction) (nearest town)


WELL PURPOSE: Home  
 (home, irrigation, municipal, industrial)

- WELL COMPLETION DATA:
- (1) diameter (inches) 2"
  - (2) total depth (feet) 25'
  - (3) static water level (feet) 5' below above top of ground.
  - (4) casing PVC, 20'  
 (material) (depth)  
 (size) if telescope see back.
  - (5) screen 5', 20'  
 (length) (depth to top)  
 (size) (material)
  - (6) pump No pump installed  
 (HP) (yield gpm)  
 (type power)
  - (7) electric log No  
 (yes or no)  
No  
 (organization running log)
  - (8) how well bottom plugged SW

DRILLERS REMARKS:

If well telescopes please sketch and show depths.

GROUND LEVEL

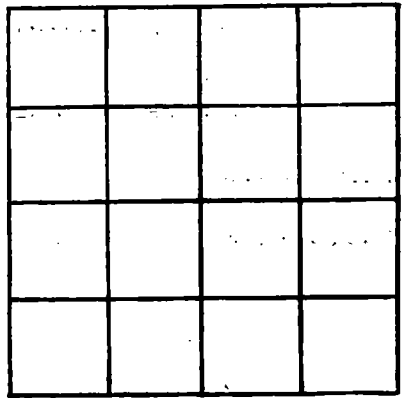

SECTION \_\_\_\_\_

Please indicate well location X.

ADDITIONAL INFORMATION

If more than one screen, show locations of each on sketch.