

MISSISSIPPI DEPARTMENT OF NATURAL RESOURCES

Bureau of Land and Water Resources

Southport Mall

P.O. Box 10631

Jackson, Mississippi 39209

Post Office Box 115

WATER WELL DRILLERS LOG

Hurley, MS 39555

Phone 588-2756

firm name

*Jackson*  
county well located

JACKSON  
M 2223

7-1-90  
date well completed

LANDOWNER: *Terri Lohrie*

description of formations encountered

from

to

*Lilly Orchard Rd*

*Sandstone*

0 20

*Helena*

*Clay*

20 45

(mailing address)

*Sand*

45 65

WELL LOCATION:

sec. 22 T-6 N R-5 E  
20 miles N of Southport  
(distance) (direction) (nearest town)

WELL PURPOSE:

(home, irrigation, municipal, industrial)

WELL COMPLETION DATA:

- (1) diameter (inches) 2"
- (2) total depth (feet) 65'
- (3) static water level (feet) 4 below top of ground.
- (4) casing PVC 60'  
(material) (depth)  
(size) if telescope see back.
- (5) screen 5' 60'  
(length) (depth to top)  
2" PVC  
(size) (material)
- (6) pump 1/2 10  
(HP) (yield gpm)  
AC  
(type power)
- (7) electric log         
(yes or no)  
(organization running log)
- (8) how well bottom plugged BWU

RECEIVED


AUG 29 1990

Department of Natural Resources  
Bureau of Land & Water Resources

DRILLERS REMARKS:

If well telescopes please sketch and show depths.

GROUND LEVEL

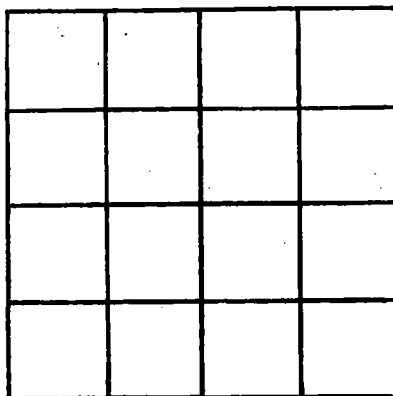

SECTION \_\_\_\_\_

Please indicate well location X.

ADDITIONAL INFORMATION

If more than one screen, show locations of each on sketch.