

MISSISSIPPI DEPARTMENT OF NATURAL RESOURCES

Bureau of Land and Water Resources

Southport Mall

P.O. Box 10631

Jackson, Mississippi 39209

SOUTHERN WATER WELL SERVICE WATER WELL DRILLERS LOG

Post Office Box 185

Hurley, MS 39555

Phone 588-7796 Firm Name

MCKEON
M 2225

8-3-90

date well completed: 19

Jackson
county well located

LANDOWNER: Miss Helena
Nutbank Rd
Helena
(mailing address)

description of formations encountered

from

to

Sand
Silt

0 10
10 35

WELL LOCATION:

sec. 9 T. 6 N. R. 5 E.
S W

_____ miles _____ of _____
(distance) (direction) (nearest town)

WELL PURPOSE:

(home, irrigation, municipal, industrial)

WELL COMPLETION DATA:

(1) diameter (inches) 2"
(2) total depth (feet) 35'
(3) static water level (feet) 10 below above
top of ground.

(4) casing PVC 30'
(material) (depth)

_____ If telescope see back.
(size)

(5) screen 5' 30'
(length) (depth to top)

2" PVC
(size) (material)

(6) pump No Pump Installed
(HP) (yield gpm)

_____ (type power)

(7) electric log _____
(yes or no)

_____ (organization running log)

(8) how well bottom plugged Blvd

DRILLERS REMARKS:


RECEIVED

AUG 29 1990

Department of Natural Resources
Bureau of Land & Water Resources

If well telescopes please sketch and show depths.

GROUND LEVEL

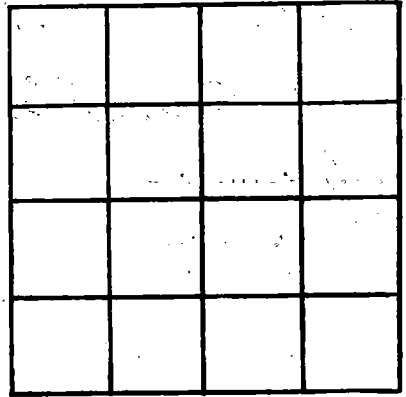

SECTION _____

Please indicate well location X.

ADDITIONAL INFORMATION

If more than one screen, show locations of each on sketch.