

MISSISSIPPI DEPARTMENT OF NATURAL RESOURCES

Bureau of Land and Water Resources

Southport Mall

P.O. Box 10631

Jackson, Mississippi 39209

SOUTHERN WATERWELL-DRILLERS LOG

Post Office Box

Hurley, MS 39555

Phone 588-2750

JACKSON  
M 2226

8-13-90 19  
date well completed

*Jackson*  
county well located

LANDOWNER: *Sam Beck*  
*old welber rd*  
*Helena*  
(mailing address)

description of formations encountered  
*sand*  
from 0 to 25

WELL LOCATION:  
sec. *10* T. *6* N R. *5* E  
*20* miles *N* of *Mosport*  
(distance) (direction) (nearest town)


WELL PURPOSE:  
*(home, irrigation, municipal, industrial)*

WELL COMPLETION DATA:  
(1) diameter (inches) *2"*  
(2) total depth (feet) *25'*  
(3) static water level (feet) *4* *(below)* above top of ground.  
(4) casing *PVC*, *20*  
(material) (depth)  
*(size)* If telescope see back.  
(5) screen *5'*, *20'*  
(length) (depth to top)  
*2"*, *PVC*  
(size) (material)  
(6) pump *1/2 hp*, *200 gpm*  
(HP) (yield gpm)  
(type power)  
(7) electric log *(yes or no)*  
(organization running log)  
(8) how well bottom plugged *PVC*

DRILLERS REMARKS:

If well telescopes please sketch and show depths.

GROUND LEVEL

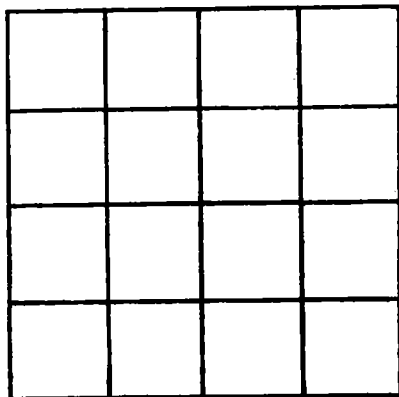

SECTION \_\_\_\_\_

Please indicate well location X.

ADDITIONAL INFORMATION

If more than one screen, show locations of each on sketch.