

MISSISSIPPI DEPARTMENT OF NATURAL RESOURCES

Bureau of Land and Water Resources

COUNTY WELL LOCATED <i>Jackson</i>	
WELL NUMBER <i>2261</i>	CODED
DATE WELL COMPLETED <i>2-7-92</i>	

PERMIT NUMBER
NAME OF DRILLING FIRM <i>Pierce Drilling Co</i>

P.O. Box 10631
Jackson, Mississippi 39209
WATER WELL DRILLERS LOG

NAME & MAILING ADDRESS OF LANDOWNER <i>Steve Alexander</i>			
<i>Helena, Ms.</i>			
WELL LOCATION:	SEC	TOWNSHIP	RANGE
	<i>28</i>	<i>6</i>	<i>5</i>
		<i>N</i>	<i>E</i>
		<i>S</i>	<i>W</i>
DISTANCE	DIRECTION	NEAREST TOWN	
<i>1/4</i>	<i>East</i>	<i>Helena</i>	
OTHER LANDMARK			
WELL PURPOSE: <input checked="" type="checkbox"/> Home <input type="checkbox"/> Irrigation, <input type="checkbox"/> Municipal, <input type="checkbox"/> Industrial, <input type="checkbox"/> Fish Pond, etc.			

PUMP DATA		
PUMP TYPE (Circle One): Submersible, Turbine, <input checked="" type="radio"/> Jet, Flowing Well, Other (Describe) _____		
POWER TYPE (Circle One): <input checked="" type="radio"/> Electric, Tractor, Diesel, Gasoline, Butane, Other (Describe) _____		
Pump Capacity (GPM)	No. of Stages	Setting Depth
<i>12</i>	<i>2</i>	<i>40</i> FT.
PUMP TEST		
Well yielded _____ GPM with a drawdown of _____ ft. after _____ hours of pumping		

WELL DATA		
Well Depth <i>210'</i>	Casing Diameter (In.) <i>2"</i>	Casing Length (Ft.) <i>200'</i>
Type of Casing <i>Plastic</i>	Hole Depth <i>210</i>	Depth to Static Water Level <i>20'</i>
TYPE OF COMPLETION: (Circle One or More): <input checked="" type="checkbox"/> Gravel Packed, <input checked="" type="checkbox"/> Underreamed, <input type="checkbox"/> Telescoped, <input type="checkbox"/> Natural Development, <input type="checkbox"/> Open Hole, <input type="checkbox"/> Other (Describe) _____		
Top of Lap Pipe or Reduction in Casing <i>-0-</i> FEET		
IF TELESCOPED OR MORE THAN ONE SCREEN: USE BACK PAGE		

LOG DATA	
TYPE OF LOG RUN (Circle One): Electric, Gamma Ray, Density, Sonic, Neutron, Other (Describe) _____	
<input checked="" type="radio"/> No Log Run	
Name of Organization Running Log	

SCREEN DATA		
Diameter - Inches <i>2"</i>	Length - Feet <i>10</i>	Slot Size - Inches <i>006</i>
Screen Type <i>Plastic</i>	Depth to Bottom - Feet <i>210</i>	


GEOLOGIC DATA (Office Use Only)			
Surface Elev.	Geologic Unit	Unit Thickness	Depth to Top
Subs. SWL	Date	Analysis	Aquifer Test
Driller's Remarks			

DESCRIPTION OF FORMATIONS ENCOUNTERED	FROM	TO
<i>Top Soil</i>	<i>0</i>	<i>10</i>
<i>Sand & Clay</i>	<i>10</i>	<i>20</i>
<i>Clay</i>	<i>20</i>	<i>30</i>
<i>Good Sand</i>	<i>30</i>	<i>100</i>
<i>Clay</i>	<i>100</i>	<i>190</i>
<i>Good Sand</i>	<i>190</i>	<i>210</i>

<div style="font-size: 2em; font-weight: bold; opacity: 0.5;">RECEIVED</div> <p style="font-size: 1.5em; margin-top: 10px;">APR 28 1992</p> <p style="text-align: center; margin-top: 10px;">Dept. of Environmental Quality Bureau of Land & Water Resources</p>
IF MORE SPACE IS NEEDED, USE BACK

If well telescopes please sketch and show depths.

GROUND LEVEL

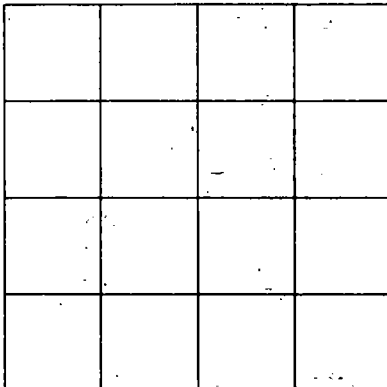

SECTION _____

Please indicate well location X.

ADDITIONAL INFORMATION

If more than one screen, show location of each on sketch.