

**MISSISSIPPI DEPARTMENT OF ENVIRONMENTAL QUALITY**  
Bureau of Land and Water Resources

P. O. Box 10631  
Jackson, MS 39289-0631  
**WATER WELL DRILLERS LOG**

COUNTY WELL LOCATED <i>Jackson</i>
WELL NUMBER (SEE CODED) <i>M2292</i>
DATE WELL COMPLETED <i>9-24-92</i>

PERMIT NUMBER
NAME OF DRILLING FIRM <i>Pierce Drilling</i>

NAME & MAILING ADDRESS OF LANDOWNER <i>Floyd Chandler</i>		
<i>Cody Road</i>		
<i>Helena, Ms</i>		
WELL LOCATION: SEC	TOWNSHIP	RANGE
<i>27</i>	<i>6</i>	<i>5</i>
	<i>(S)</i>	<i>(W)</i>
DISTANCE	DIRECTION	NEAREST TOWN
<i>6</i> Miles	<i>W</i>	<i>Mobile Co. Line</i>
OTHER LANDMARK		
WELL PURPOSE: <input checked="" type="checkbox"/> Home Irrigation, Municipal, Industrial, Fish Pond, etc.		

<b>PUMP DATA</b>		
PUMP TYPE (Circle One): Submersible, Turbine, <input checked="" type="radio"/> Jet, Flowing Well, Other (Describe)		
POWER TYPE (Circle One): <input checked="" type="radio"/> Electric, Tractor, Diesel, Gasoline, Butane, Other (Describe) H/P <i>1</i>		
Pump Capacity (GPM) <i>10</i>	No. of Stages <i>2</i>	Setting Depth <i>20</i> FT.
PUMP TEST		
Well yielded <i>10</i> GPM with a drawdown of <i>10</i> ft. after <i>1</i> hours of pumping		

<b>WELL DATA</b>		
Well Depth <i>110</i>	Casing Diameter (In.) <i>2"</i>	Casing Length (Ft.) <i>100</i>
Type of Casing <i>Plastic</i>	Hole Depth <i>110</i>	Depth to Static Water Level <i>5'</i>
TYPE OF COMPLETION: (Circle One or More): <input checked="" type="checkbox"/> Gravel Packed, <input type="checkbox"/> Underreamed, <input type="checkbox"/> Telescoped, <input checked="" type="checkbox"/> Natural Development, <input type="checkbox"/> Open Hole, <input type="checkbox"/> Other (Describe)		
Top of Lap Pipe or Reduction in Casing <i>0</i> FEET IF TELESCOPED OR MORE THAN ONE SCREEN: USE BACK PAGE		

<b>LOG DATA</b>	
TYPE OF LOG RUN (Circle One): Electric, Gamma Ray, Density, Sonic, Neutron, Other (Describe) <input checked="" type="radio"/> No Log Run.	
Name of Organization Running Log	

<b>SCREEN DATA</b>		
Diameter - Inches <i>2"</i>	Length - Feet <i>10'</i>	Slot Size - Inches <i>006</i>
Screen Type <i>Plastic</i>	Depth to Bottom - Feet <i>110</i>	


<b>GEOLOGIC DATA (Office Use Only)</b>			
Surface Elev.	Geologic Unit	Unit Thickness	Depth to Top
Subs. SWL	Date	Analysis	Aquifer Test
Driller's Remarks			

DESCRIPTION OF FORMATIONS ENCOUNTERED	FROM	TO
<i>Top Soil</i>	<i>0</i>	<i>10</i>
<i>Clay</i>	<i>10</i>	<i>30</i>
<i>Good Sand</i>	<i>30</i>	<i>80</i>
<i>Clay</i>	<i>80</i>	<i>100</i>
<i>Good Sand</i>	<i>100</i>	<i>110</i>

FORMATIONS (Continued)	FROM	TO
<b>RECEIVED</b>		
<i>NOV 25 1992</i>		
Dept. of Environmental Quality Bureau of Land & Water Resources		
IF MORE SPACE IS NEEDED, USE BACK		

If well telescopes please sketch and show depths.


GROUND LEVEL

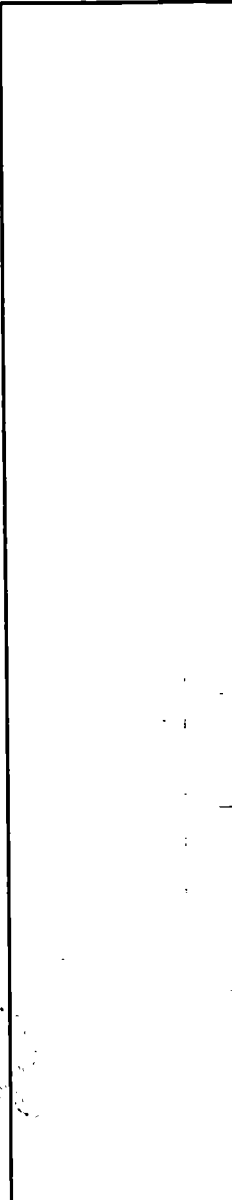


SECTION \_\_\_\_\_

Please indicate well location X.

ADDITIONAL INFORMATION

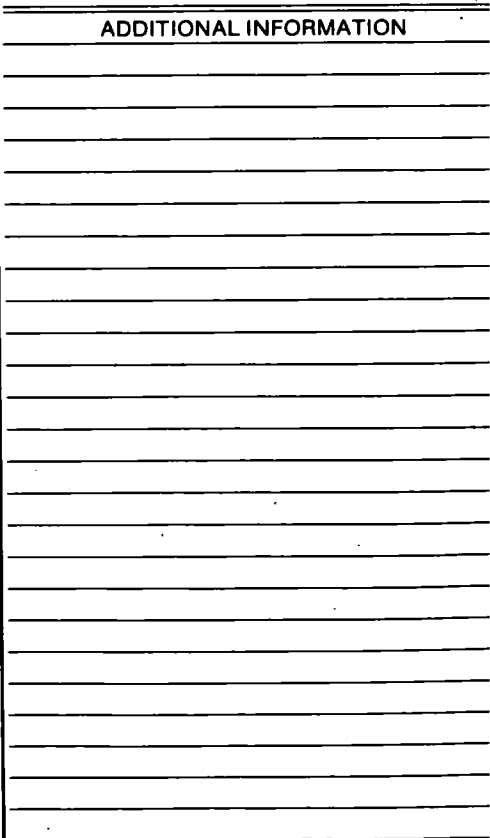

If more than one screen, show location of each on sketch.