

MISSISSIPPI DEPARTMENT OF ENVIRONMENTAL QUALITY
Bureau of Land and Water Resources

P. O. Box 10631
Jackson, MS 39289-0631
WATER WELL DRILLERS LOG

COUNTY WELL LOCATED JACKSON	
WELL NUMBER M 2281	CODED
DATE WELL COMPLETED 5-21-93	

PERMIT NUMBER
NAME OF DRILLING FIRM Coastal Water Well Ser. Inc.

NAME & MAILING ADDRESS OF LANDOWNER D. H. Harrison Thibault Rd.			
WELL LOCATION:	SEC 15	TOWNSHIP 6 N	RANGE 5 W
DISTANCE 2 1/4 Miles	DIRECTION NE	NEAREST TOWN of HELENA	
OTHER LANDMARK			
WELL PURPOSE (Home Irrigation, Municipal, Industrial, Fish Pond, etc.)			


PUMP DATA		
PUMP TYPE (Circle One): Submersible, Turbine, Jet, Flowing Well, Other (Describe) _____		
POWER TYPE (Circle One): Electric, Tractor, Diesel, Gasoline, Butane, Other (Describe) _____ H/P _____		
Pump Capacity (GPM)	No. of Stages	Setting Depth FT.
PUMP TEST		
Well yielded _____ GPM with a drawdown of _____ ft. after _____ hours of pumping		

WELL DATA		
Well Depth 192'	Casing Diameter (In.) 2"	Casing Length (Ft.) 192'
Type of Casing PVC	Hole Depth 195'	Depth to Static Water Level 20'
TYPE OF COMPLETION: (Circle One or More): <input checked="" type="checkbox"/> Gravel Pack, <input type="checkbox"/> Underreamed, <input type="checkbox"/> Telescoped, <input checked="" type="checkbox"/> Natural Development, <input type="checkbox"/> Open Hole, <input type="checkbox"/> Other		
Top of Lap Pipe or Reduction in Casing FEET IF TELESCOPED OR MORE THAN ONE SCREEN: USE BACK PAGE		

LOG DATA	
TYPE OF LOG RUN (Circle One): Electric, Gamma Ray, Density, Sonic, Neutron, Other (Describe) _____	
Name of Organization Running Log	

SCREEN DATA		
Diameter - Inches 2"	Length - Feet 10'	Slot Size - Inches .008
Screen Type PVC	Depth to Bottom - Feet 192'	


GEOLOGIC DATA (Office Use Only)			
Surface Elev.	Geologic Unit	Unit Thickness	Depth to Top
Subs. SWL	Date	Analysis	Aquifer Test
Driller's Remarks			

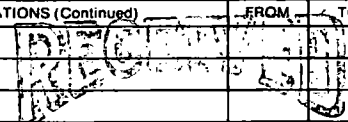DESCRIPTION OF FORMATIONS ENCOUNTERED	FROM	TO	FORMATIONS (Continued)	FROM	TO
top soil	0	2	 JUL 26 1993 Dept. of Environmental Quality Office of Land & Water Resources		
yellow/grey clay	2	20			
coarse sand/gravel	20	60			
blue clay sand	60	140			
med. sand	140	150			
blue clay	150	175			
med. sand	175	192			
blue clay	192	195			

IF MORE SPACE IS NEEDED, USE BACK

If well telescopes please
sketch and show depths.

GROUND LEVEL

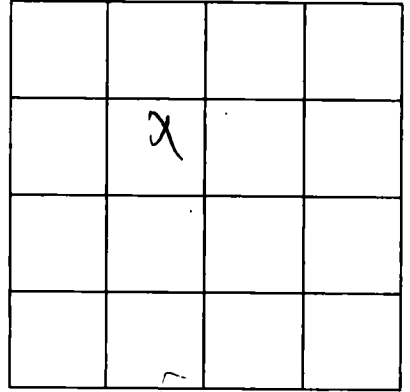

SECTION

15

Please indicate well location X.

ADDITIONAL INFORMATION

If more than one screen,
show location of each on sketch.