

M

JACKSON
 M 2296
 11-15-78

MISSISSIPPI
 BOARD OF WATER COMMISSIONERS
 416 North State Street
 Jackson, Mississippi 39201

WATER WELL DRILLERS LOG

11/15 19 78 Boyle Drilling Co. Jackson
 date well completed firm name county well located

LANDOWNER: <u>Boyle</u>	description of formations encountered	from	to
<u>Demoucy</u> <u>Forts Lake</u> (mailing address)	<u>sandy clay</u>	<u>0</u>	<u>22</u>
	<u>sand</u>	<u>22</u>	<u>44</u>
	<u>blue clay</u>	<u>44</u>	<u>66</u>
	<u>yellow clay</u>	<u>66</u>	<u>70</u>
	<u>fine sand</u>	<u>70</u>	<u>88</u>
	<u>sand</u>	<u>88</u>	<u>05</u>

LANDOWNER: Boyle
Demoucy
Forts Lake
 (mailing address)

WELL LOCATION:
 sec 17 T 6 N R 4 E
15 miles NE of MP
 (distance) (direction) (nearest town)

WELL PURPOSE: home
 (home, irrigation, municipal, industrial)

WELL COMPLETION DATA:

- (1) diameter (inches) 2
- (2) total depth (feet) 105
- (3) static water level (feet) 31 below above top of ground.
- (4) casing plastic, 100,
 (material) (depth)
 (size) If telescope see back.
- (5) screen 5', 100
 (length) (depth to top)
2", plastic
 (size) (material)
- (6) pump 1/2,
 (HP) (yield gpm)
electric
 (type power)
- (7) electric log no
 (yes or no)
 (organization running log)
- (8) how well bottom-plugged Brick
value

RECEIVED


JAN 9 1978

DRILLERS REMARKS:

MISS. BD OF WATER COM.

If well telescopes please sketch and show depths.

GROUND LEVEL

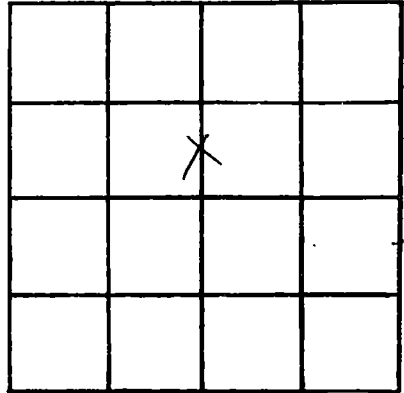

SECTION 17

Please indicate well location X.

ADDITIONAL INFORMATION

If more than one screen, show locations of each on sketch.