

MISSISSIPPI DEPARTMENT OF ENVIRONMENTAL QUALITY

Office of Land and Water Resources

P. O. Box 10631
Jackson, MS 39289-0631
WATER WELL DRILLERS LOG

COUNTY WELL LOCATED <i>Jackson</i>	
WELL NUMBER <i>M2797</i>	CODED
DATE WELL COMPLETED <i>1-13-94</i>	

PERMIT NUMBER
NAME OF DRILLING FIRM <i>Coast Water Well Service</i>

NAME & MAILING ADDRESS OF LANDOWNER <i>Donnie Smith</i>			
<i>Hatfield Rd.</i>			
<i>Pascagoula, Ms</i>			
WELL LOCATION: SEC	TOWNSHIP	RANGE	
<i>32</i>	<i>6^N</i>	<i>5^W</i>	
DISTANCE	DIRECTION	NEAREST TOWN	
<i>3</i> Miles	<i>NE</i>	of <i>Escatawpa</i>	
OTHER LANDMARK			
WELL PURPOSE <input checked="" type="radio"/> Home, <input type="radio"/> Irrigation, <input type="radio"/> Municipal, <input type="radio"/> Industrial, <input type="radio"/> Fish Pond, etc.			

PUMP DATA		
PUMP TYPE (Circle One): Submersible, Turbine, Jet, Flowing Well, Other (Describe) _____		
POWER TYPE (Circle One): Electric, Tractor, Diesel, Gasoline, Butane, Other (Describe) _____ H/P _____		
Pump Capacity (GPM)	No. of Stages	Setting Depth FT.
PUMP TEST		
Well yielded _____ GPM with a drawdown of _____ ft. after _____ hours of pumping		

WELL DATA		
Well Depth <i>246</i>	Casing Diameter (In.) <i>2"</i>	Casing Length (Fl.) <i>236'</i>
Type of Casing <i>PVC</i>	Hole Depth <i>246'</i>	Depth to Static Water Level <i>25'</i>

LOG DATA	
TYPE OF LOG RUN (Circle One): Electric, Gamma Ray, Density, Sonic, Neutron, Other (Describe) _____ <i>No Log Run</i>	
Name of Organization Running Log	

TYPE OF COMPLETION: (Circle One or More):
 Gravel Packed Underreamed, Telescoped,
 Natural Development Open Hole, Other
 (Describe) _____

GEOLOGIC DATA (Office Use Only)			
Surface Elev.	Geologic Unit	Unit Thickness	Depth to Top
Subs. SWL	Date	Analysis	Aquifer Test

WELL GROUTED TO A DEPTH OF *20* FEET
 Type Grout (circle one): Cement, Bentonite, or Mix

Driller's Remarks			


SCREEN DATA		
Diameter - Inches <i>2"</i>	Length - Feet <i>10'</i>	Slot Size - Inches <i>.008</i>
Screen Type <i>PVC</i>	Depth to Bottom - Feet <i>246'</i>	

DESCRIPTION OF FORMATIONS ENCOUNTERED	FROM	TO
<i>Top Soil</i>	<i>0</i>	<i>2</i>
<i>Yellow & Gray Clay</i>	<i>2</i>	<i>10</i>
<i>Coarse Sand & Gravel</i>	<i>10</i>	<i>70</i>
<i>Blue Clay streaks sand</i>	<i>70</i>	<i>200</i>
<i>Medium to Coarse sand</i>	<i>200</i>	<i>246</i>

FORMATIONS (Continued)	FROM	TO
RECEIVED		
FEB 18 1994		
Dept. of Environmental Quality Office of Land & Water Resources		
IF MORE SPACE IS NEEDED, USE BACK		

If well telescopes please sketch and show depths.

GROUND LEVEL

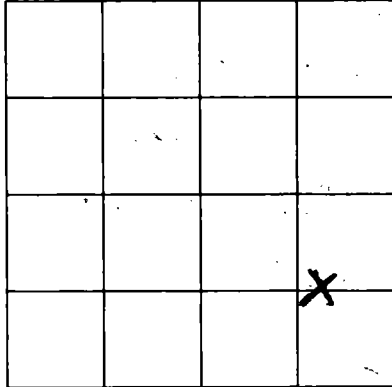

SECTION 92

Please indicate well location X.

ADDITIONAL INFORMATION

Series of horizontal lines for additional information.

If more than one screen, show location of each on sketch.