

MISSISSIPPI DEPARTMENT OF NATURAL RESOURCES

Bureau of Land and Water Resources

Southport Mall

P.O. Box 10631

Jackson, Mississippi 39209

WATER WELL DRILLERS LOG

JACKSON
~~2140~~
~~2120~~

M2304

12-8 1986 date well completed *de Pierce Drilling Co.* firm name *Jackson* county well located


LANDOWNER: *Bezz Watson*
Three Rivers
Pascagoula, MS
 (mailing address)

description of formations encountered	from	to
<i>top soil</i>	<i>0</i>	<i>10</i>
<i>clay</i>	<i>10</i>	<i>25</i>
<i>good sand</i>	<i>25</i>	<i>85</i>
<i>clay</i>	<i>85</i>	<i>140</i>
<i>good sand</i>	<i>140</i>	<i>160</i>

WELL LOCATION:
 sec. *36* T. *10* N. R. *5* E
3 miles *SW* of *Big Point*
 (distance) (direction) (nearest town)

WELL PURPOSE:
 (home, irrigation, municipal, industrial)

WELL COMPLETION DATA:
 (1) diameter (inches) *2"*
 (2) total depth (feet) *160'*
 (3) static water level (feet) *30'* *below* above top of ground.
 (4) casing *plastic, 155'*
 (material) (depth)
0 If telescope see back.
 (size)
 (5) screen *5'*, *160'*
 (length) (depth to top)
006, plastic
 (size) (material)
 (6) pump *1* (HP) *10* (yield gpm)
electric
 (type power)
 (7) electric log *(yes or no)*
 (organization running log)
 (8) how well bottom plugged *BW*

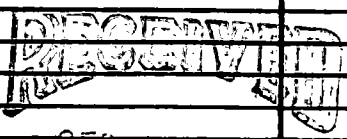


SEP 15 1987

Department of Natural Resources
 Bureau of Land & Water Resources

DRILLERS REMARKS:

If well telescopes please sketch and show depths.

GROUND LEVEL

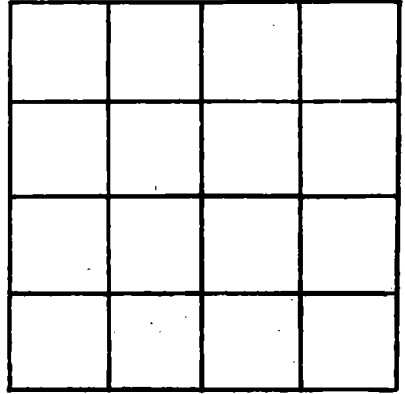

SECTION _____

Please indicate well location X.

ADDITIONAL INFORMATION

If more than one screen, show locations of each on sketch.