

MISSISSIPPI DEPARTMENT OF ENVIRONMENTAL QUALITY

Office of Land and Water Resources

P. O. Box 10631
Jackson, MS 39289-0631
WATER WELL DRILLERS LOG

COUNTY WELL LOCATED
Jackson

WELL NUMBER CODED
A 2329

DATE WELL COMPLETED
7-26-96

PERMIT NUMBER

NAME OF DRILLING FIRM
Coast Water Well Service

NAME & MAILING ADDRESS OF LANDOWNER
Robert Beasley
Prariebrook Rd
Pascagoula, Ms.

WELL LOCATION: SEC TOWNSHIP RANGE
10 6 5

DISTANCE DIRECTION NEAREST TOWN
3 Miles *S* of *Big Point*

OTHER LANDMARK

WELL PURPOSE Home Irrigation, Municipal, Industrial, Fish Pond, etc.

PUMP DATA

PUMP TYPE (Circle One):
Submersible, Turbine, Jet, Flowing Well,
Other (Describe) _____

POWER TYPE (Circle One):
Electric, Tractor, Diesel, Gasoline, Butane,
Other (Describe) _____ H/P _____

Pump Capacity (GPM) No. of Stages Setting Depth _____ FT.

PUMP TEST
Well yielded _____ GPM with
a drawdown of _____ ft.
after _____ hours of pumping

WELL DATA

Well Depth Casing Diameter (In.) Casing Length (Ft.)
299' *2"* *289'*

Type of Casing Hole Depth Depth to Static Water Level
PVC *299'* *7'*

TYPE OF COMPLETION: (Circle One or More):
 Gravel Packed, Underreamed, Telescoped,
 Natural Development, Open Hole, Other
(Describe) _____

WELL GROUTED TO A DEPTH OF *20'* FEET
Type Grout (circle one): Cement, Bentonite, or Mix

LOG DATA

TYPE OF LOG RUN (Circle One):
Electric, Gamma Ray, Density, Sonic, No Log Run, Neutron,
Other (Describe) _____

Name of Organization Running Log

SCREEN DATA

Diameter - Inches Length - Feet Slot Size - Inches
2" *10'* *.008"*

Screen Type Depth to Bottom - Feet
PVC *299'*

GEOLOGIC DATA (Office Use Only)

Surface Elev.	Geologic Unit	Unit Thickness	Depth to Top
Subs. SWL	Date	Analysis	Aquifer Test

Driller's Remarks

RECEIVED

Top of Lap Pipe or Reduction in Casing _____ FEET

IF TELESCOPED OR MORE THAN ONE SCREEN, USE BACK PAGE


DESCRIPTION OF FORMATIONS ENCOUNTERED	FROM	TO	FORMATIONS (Continued)	FROM	TO
<i>Top Soil</i>	<i>0</i>	<i>2</i>			
<i>White coarse sand</i>	<i>2</i>	<i>2.5</i>			
<i>Blue Clay</i>	<i>2.5</i>	<i>3.5</i>			
<i>White coarse sand</i>	<i>3.5</i>	<i>13.3</i>			
<i>Blue Clay</i>	<i>13.3</i>	<i>14.5</i>			
<i>Grey coarse sand</i>	<i>14.5</i>	<i>21.5</i>			
<i>Blue Clay</i>	<i>21.5</i>	<i>240</i>			
<i>Grey coarse sand</i>	<i>240</i>	<i>299</i>			

Dept. of Environmental Quality
Office of Land & Water Resources

IF MORE SPACE IS NEEDED, USE BACK

If well telescopes please sketch and show depths.

GROUND LEVEL

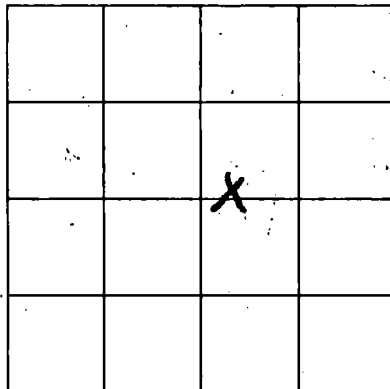

SECTION 10

Please indicate well location X.

ADDITIONAL INFORMATION

If more than one screen,
show location of each on sketch.