

MISSISSIPPI DEPARTMENT OF ENVIRONMENTAL QUALITY

Office of Land and Water Resources

P. O. Box 10631
Jackson, MS 39289-0631
WATER WELL DRILLERS LOG

COUNTY WELL LOCATED
Jackson

WELL NUMBER CODED
M 2363

DATE WELL COMPLETED
10-2-97

PERMIT NUMBER

NAME OF DRILLER OR FIRM
Coastal Water Well Service

NAME & MAILING ADDRESS OF LANDOWNER
*Steve Lynn
Lyons Lake Rd.
Pascagoula, Ms*

WELL LOCATION SEC TOWNSHIP RANGE
23 6 5 W

DISTANCE DIRECTION NEAREST TOWN
3 Miles EAST of Helena

OTHER LANDMARK

WELL PURPOSE: Home Irrigation, Municipal, Industrial, Fish Pond, etc.

PUMP DATA

PUMP TYPE (Circle One):
Submersible, Turbine, Jet, Flowing Well,
Other (Describe) _____

POWER TYPE (Circle One):
Electric, Tractor, Diesel, Gasoline, Butane,
Other (Describe) _____ H/P _____

Pump Capacity (GPM) No. of Stages Setting Depth _____ FT.

PUMP TEST

Well yielded _____ GPM with
a drawdown of _____ ft.
after _____ hours of pumping

WELL DATA

Well Depth Casing Diameter (In.) Casing Length (Ft.)
235' 2" 225'

Type of Casing Hole Depth Depth to Static Water Level
PVC 235' 10'

TYPE OF COMPLETION: (Circle One or More):
 Gravel Packed, Underreamed, Telescoped,
 Natural Development, Open Hole, Other
(Describe) _____

LOG DATA

TYPE OF LOG RUN (Circle One): (No Log Run)
Electric, Gamma Ray, Density, Sonic, Neutron,
Other (Describe) _____

Name of Organization Running Log _____

WELL GROUTED TO A DEPTH OF *2* FEET
Type Grout (circle one): Cement, Bentonite or Mix

GEOLOGIC DATA (Office Use Only)

Surface Elev.	Geologic Unit	Unit Thickness	Depth to Top
Subs. SWL	Date	Analysis	Aquifer Test

SCREEN DATA

Diameter - Inches Length - Feet Slot Size - Inches
2" 10' .004

Screen Type Depth to Bottom - Feet
PVC wrapped 235'

Driller's Remarks

Top of Lap Pipe or Reduction in Casing

FEET IF TELESKOPED OR MORE THAN ONE SCREEN: USE BACK PAGE

DESCRIPTION OF FORMATIONS ENCOUNTERED	FROM	TO
<i>Top Soil</i>	<i>0</i>	<i>2</i>
<i>Brown Clay</i>	<i>2</i>	<i>18</i>
<i>White Coarse Sand</i>	<i>18</i>	<i>50</i>
<i>Blue Clay</i>	<i>50</i>	<i>80</i>
<i>White Coarse Sand</i>	<i>80</i>	<i>110</i>
<i>Blue Clay</i>	<i>110</i>	<i>211</i>
<i>Med Gray Sand</i>	<i>211</i>	<i>235</i>

FORMATIONS (Continued)

FROM TO

RECEIVED


DEC 08 1997

Dept. of Environmental Quality
Office of Land & Water Resources

IF MORE SPACE IS NEEDED, USE BACK

If well telescopes please
sketch and show depths.

GROUND LEVEL

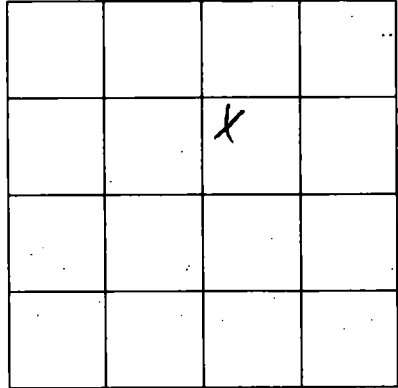


SECTION

23

Please indicate well location X.

ADDITIONAL INFORMATION

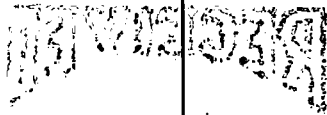

If more than one screen,
show location of each on sketch.