

MISSISSIPPI DEPARTMENT OF ENVIRONMENTAL QUALITY

Office of Land and Water Resources

P. O. Box 10631
Jackson, MS 39289-0631
WATER WELL DRILLERS LOG

COUNTY WELL LOCATED
Jackson

WELL NUMBER *M 2599* CODED

DATE WELL COMPLETED
10-15-99

PERMIT NUMBER

NAME OF DRILLING FIRM
Coast Water Well Service

NAME & MAILING ADDRESS OF LANDOWNER
Drey Parker
Eckhoff Rd
Pascagoula, Mo.

WELL LOCATION SEC *15* TOWNSHIP *6 N* RANGE *5 W*

DISTANCE *2* Miles DIRECTION *NE* of NEAREST TOWN *Helena*

OTHER LANDMARK

WELL PURPOSE Home, Irrigation, Municipal, Industrial, Fish Pond, etc.

PUMP DATA

PUMP TYPE (Circle One):
Submersible, Turbine, Jet, Flowing Well,
Other (Describe) _____

POWER TYPE (Circle One):
 Electric, Tractor, Diesel, Gasoline, Butane,
Other (Describe) _____ H/P *1*

Pump Capacity (GPM) *9* No. of Stages *2* Setting Depth _____ FT.

PUMP TEST

Well yielded _____ GPM with
a drawdown of _____ ft.
after _____ hours of pumping

WELL DATA

Well Depth *220* Casing Diameter (In) *2"* Casing Length (Ft.) *210*

Type of Casing *PVC* Hole Depth *220* Depth to Static Water Level *15'*

LOG DATA

TYPE OF LOG RUN (Circle One):
Electric, Gamma Ray, Density, Sonic, No Log Run, Neutron,
Other (Describe) _____

Name of Organization Running Log _____

TYPE OF COMPLETION: (Circle One or More):
 Gravel Packed, Underreamed, Telescoped,
 Natural Development, Open Hole, Other
(Describe) _____

WELL GROUTED TO A DEPTH OF *20* FEET
Type Grout (circle one): Cement, Bentonite, or Mix

GEOLOGIC DATA (Office Use Only)

Surface Elev.	Geologic Unit	Unit Thickness	Depth to Top
Subs. SWL	Date	Analysis	Aquifer Test

SCREEN DATA

Diameter - Inches *2"* Length - Feet *10'* Slot Size - Inches *.008*

Screen Type *PVC* Depth to Bottom - Feet *220'*

Driller's Remarks

Top of Lap Pipe or Reduction in Casing


FEET IF TELESCOPED OR MORE THAN ONE SCREEN: USE BACK PAGE

DESCRIPTION OF FORMATIONS ENCOUNTERED	FROM	TO	FORMATIONS (Continued)	FROM	TO
<i>Top Soil</i>	<i>0</i>	<i>2</i>			
<i>Red Clay</i>	<i>2</i>	<i>19</i>			
<i>White Coarse sand</i>	<i>19</i>	<i>65</i>			
<i>Blue Clay</i>	<i>65</i>	<i>80</i>			
<i>Gray Coarse sand</i>	<i>80</i>	<i>165</i>			
<i>Blue Clay</i>	<i>165</i>	<i>175</i>			
<i>Gray Coarse sand</i>	<i>175</i>	<i>220</i>			

IF MORE SPACE IS NEEDED, USE BACK

If well telescopes please sketch and show depths.

GROUND LEVEL

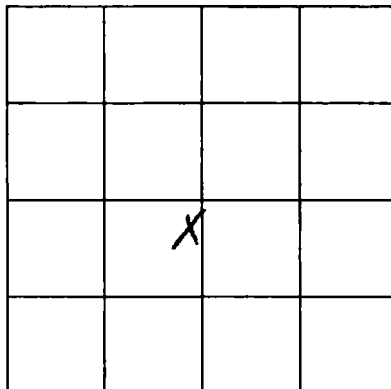

SECTION 15

Please indicate well location X.

ADDITIONAL INFORMATION

If more than one screen,
show location of each on sketch.