

# JACKSON MISSISSIPPI BOARD OF WATER COMMISSIONERS

N 14

8-12-60

## WATER WELL DRILLERS LOG



Date: Aug 12, 1960, Driller: C. J. Switzer Well Co. County Jackson

35

(Name)

- (1) Owner of Land: George Calander  
(Name)  
on Cook's Road North  
of Ocean Springs  
1/2 mile on left side of road
- (2) Location: NE 1/4, NE 1/4, Sec. 4, T 7 R 9  
3 miles N. of Ocean Springs  
(distance) (direction) (Nearest Town)
- (3) Topography:  (Level)  
(Hilly) (Flat)
- (4) Purpose of Well: domestic  
(Domestic Irrigation Municipal, Industrial, Other)

Description & Color of Materials Sand, Clay, Red Clay, Shell, etc.	Thick- ness Feet	Depth Feet
Surface	0	8
Sand	8	22
Clay	22	45
sand and gravel	45	60
Clay	60	395
good sand	395	455

### Information upon completion of well:


- (1) Diameter: 2 inches.
- (2) Total Depth: 452 feet.
- (3) Water Level: 19' feet below top of ground.
- (4) Cased to: 452' Size 2"  
2" x 10"
- (5) Screen: Size 10ga Length -
- (6) Were any formations sealed against pollution?  
 yes,  no.

997  
 992  
 -15

If YES depth of formation 10 feet

Why Health dept. requirement

Drillers Remarks:

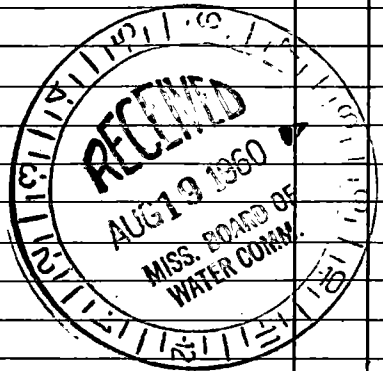

(Use Back Side)

Well No.

CONFIDENTIAL

CONFIDENTIAL

